


CORNER updates see 6 T315 R2W
DUE TO BURN - 8-2015
CORNER DATA ON M-166-27

CC $\frac{6}{7}$ 100600
NEW BT 5" FIR S43°E 15' FT
SCRIBED T315 R2W S7 BT

S $\frac{1}{16}$ S60N14 O.K


CS $\frac{1}{16}$ O.K

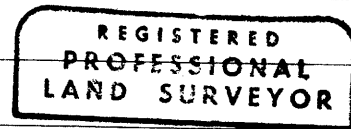

S.E $\frac{1}{16}$ O.K

Emil Quimby

C.E $\frac{1}{16}$ O.K

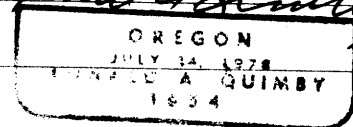

EXP 12-31-16

$\frac{1}{4}$ COR 6/5 200640 O.K

$\frac{1}{4}$ COR $\frac{6}{7}$ 140600 O.K

Sec COR $\frac{6}{5}$ 200600
 $\frac{7}{8}$ NEW BT 4" YEW N50°E 32'
SCRIBED T315 R2W S5 BT

ADDED SPIKES TO SIDE-CENTER OF ALL TREES

FILED

Date: 10/5/2015 By: X

This survey consists of:

Map: _____

Narrative: _____

Corner Rpt: CS 65/89-40

DOUGLAS COUNTY
SURVEYOR

C.S. File No 65/89-40