

FILED

Date: 10-5-2015 By: JC

This survey consists of:

Map: \_\_\_\_\_

Narrative: \_\_\_\_\_

Corner Rpt: CS 65 | 89-41

DOUGLAS COUNTY SURVEYOR

CORNER REPORT FORM

Section 6 Township 32S Range 4W  
Douglas County Date 9/2015  
PLSS Number 100700

CORNER DESIGNATION

Township COR T31S  
R 536 | 531 R  
S 51 | 56 4  
W 51 | 56 W  
T32S



Condition Report only  
Not Found  
Renewed  
Unrecorded  
Surveyed In  
Referenced out

Previous Renewals/Surveys, etc:

Byars 1882 V 18 Pg 7782 MARKHAM 1951 CS 40/312 Templin 1994  
Bushey 1893 V 18 Pg 7853 TEMPLIN 1958 CS 42/389 PP 1995-0115  
BLM Resurvey 1972-1973 Vol 38 Pg 15641

Monument(s) & Accessories Found: (Condition and Source)

3" BLM BRASS CAP  
38" FIR STUMP N62E 21.8FT Badly Decayed  
25" FIR N 63E 31.0FT GOOD SCAR  
63" FIR STUMP S74E 28.0FT VIS. SCAR  
18" FIR STUMP S5DE 35.0FT  
8" FIR S57E 22.9FT GOOD SCAR  
42" FIR S62W 38.9FT GOOD SCAR  
17" CEDAR N127W 16.5FT GOOD SCAR

Monument Detail

Sketch

Monument Set (Procedures and Description)

New Accessories

Location & Comments

CORNER IS ON A  
N.E Slope Approx  
500' West of Road

N 42° 49' 33.5E"  
W 123° 13' 42.07"

Compass Declination 15 1/2° E

Firm/Agency: I.e. Engineering, Inc.





Address: 809 SE Pine St., Roseburg, OR 97470

Party Chief: N. FROMDAHL

Notes:

Witness: R. OLSON

Surveyor's Seal

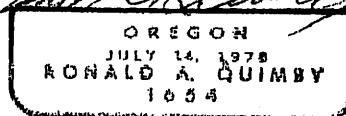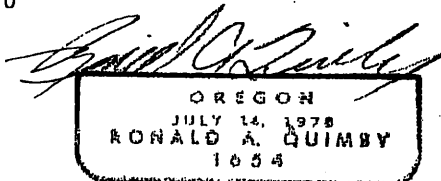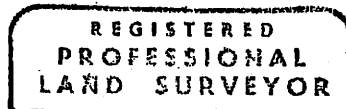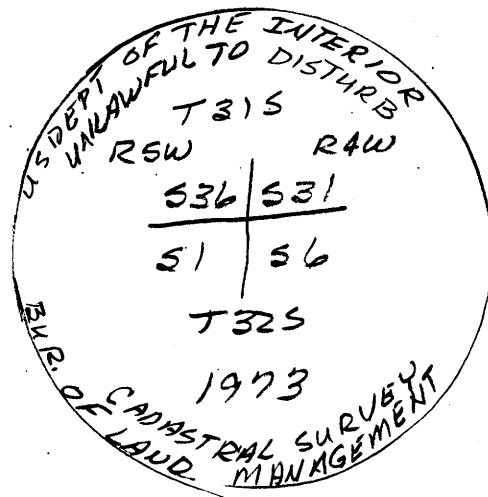

EXP 12-31-16

C.S. File 65 | 89-41