

FILED

Date: 11-17-2015 By: JC

This survey consists of:

Map: _____

Narrative: _____

Corner Rpt: CS 65/89-56

OREGON CORNER RESTORATION FORM

SECTION 5, 6, 7 & 8 TOWNSHIP 21 S. RANGE 11 W. W.M.

DOUGLAS COUNTY
SURVEYOR

Corner Designation


SECTION CORNER SECTIONS 5, 6, 7 & 8
GCDB/PLSS CORNER ID No. 200600

Previous Renewals / Surveys, etc.:

C.S. FILE 54/1, C.S. FILE 59/26,
M78-76 AND M93-10

- ___ Condition Report Only
- ___ Not Found
- Renewed
- ___ Unrecorded
- ___ Surveyed in
- ___ Referenced Out

Monument Detail Sketch

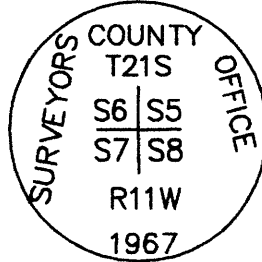

Monument Found or Set (Procedures and Description)

FOUND MONUMENT:

A 2 1/2" BRASS CAP ON 1" IRON PIPE MARKED "T21S R11W S5 S6 S7 S8 1967"
ALONG SIDE ROTTEN ORIGINAL CORNER TREE STUMP PER CS#54/1.

FOUND BT'S:

- A ROTTEN ORIGINAL CEDAR SNAG BEARS N12°30'E 15.2'.
- A ROTTEN CEDAR STUMP BEARS N46°30'W 27.0'.
- A ROTTEN ORIGINAL FIR STUMP BEARS N21°W 18.5'.

New Accessories

NEW BT'S MARKED:

- A 43" FIR BARK SCRIBED "SW S5 BT" WITH X-CHOP AND TAG BEARS N21°E 31.5'
TO A SPIKE AT SIDE CENTER.
- A 29" SPRUCE FACE SCRIBED "SE S6 BT" WITH X-CHOP AND TAG BEARS N85°W 31.0'
TO A SPIKE AT SIDE CENTER.

Locations & Comments


LAT. AND LONG. PER GARMEN ETREX HAND HELD GPS
N: 43°46'09.2" W: 124°02'43.6"

Compass Declination 18° EAST
 Firm / Agency: Estabrook Land Surveying Inc.
 Address: PO BOX 574, Lakeside, OR 97449
 Party Chief: Jerry Estabrook
 Notes:
 Witness: Josh Maxwell & Pat Coy
 DATE 9/26/15

Surveyors Seal



A handwritten signature in black ink that reads "Jerry Lee Estabrook".

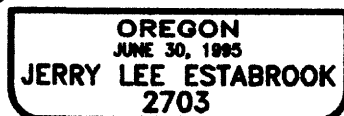

EXPIRES 12/31/15

C.S. File No 65/89-56