

FILED

Date: 11-30-2015 By: JC  
This survey consists of:  
\_\_\_\_\_  
\_\_\_\_\_  
County: CS 65 | 89-60

# CORNER NOTES

September 15, 2015

BY: TONY HOSTETTER  
63538 PINTAIL DR.  
COOS BAY, OR 97420

DOUGLAS COUNTY  
SURVEYOR

FOR: WEYERHAEUSER COMPANY  
98674 DELLWOOD LANE  
COOS BAY, OR 97420

**W 1/4 CORNER, SECTION 32, T.24 S., R.9 W., W.M.**  
**GCBD/PLSS CORNER ID NO. 200140**  
DOUGLAS COUNTY, OREGON

FOUND: 3/4" IRON PIPE, SET BY WEYERHAEUSER 1964 FROM OBT WHICH WAS N 22°E, 22.8 FEET ( GLO: N20°E, 27.1 FEET ) AND OBT WHICH WAS S06°W, 25.8 FEET ( GLO: S06°W, 24.4 FEET ). BOTH OF THESE BTS ARE GONE. THE WEYERHAEUSER INFORMATION IS FROM CONDENSED CORNER BOOK RECORD, THE 1964 FIELD NOTES ARE NOT AVAILABLE.

FROM WHICH:

40" FIR STUMP, WEYCO BT, NO EVIDENCE,  
BEARS; S 38°30'E, 73.7 FEET TO CENTER.

38" FIR STUMP, WEYCO BT, NO EVIDENCE,  
BEARS; S 20°30'W, 59.1 FEET TO CENTER.

Note: Weyerhaeuser bearings typically measured with a staff compass.

NEW BTS:


25" FIR SCRIBED "S32 1/4 BT", BT TAG,  
BEARS: N 17°E, 10.4 FEET TO 6" SPIKE, PLACED BELOW FACE.

12" FIR, SCRIBED "S32 1/4 BT", BT TAG,  
BEARS: S 48°E, 5.60 FEET TO 6" SPIKE, PLACED BELOW FACE.

16" FIR, SCRIBED "S31 1/4 BT", BT TAG,  
BEARS: N 47°W, 12.8 FEET TO 6" SPIKE, PLACED BELOW FACE

Note: new BT bearings determined by hand compass ( declination 18°E )

W QU 32-24-9.DOC

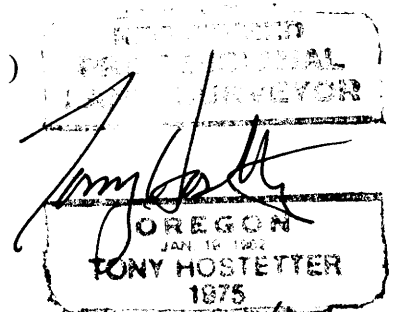

C.S. File No 65/89-60 EXPIRES: 6/30/17