

FILED

Date: 6-1-2015 By: X

This survey consists of:

Map: \_\_\_\_\_

Narrative: \_\_\_\_\_

Corner Rpt. C.S. 65/89-66

DOUGLAS COUNTY  
SURVEYOR

## ***CORNER NOTES***

September 15, 2015

BY: TONY HOSTETTER  
63538 PINTAIL DR.  
COOS BAY, OR 97420

FOR: WEYERHAEUSER COMPANY  
98674 DELLWOOD LANE  
COOS BAY, OR 97420

***SE CORNER, SECTION 2, T.25 S., R.9 W., W.M.***  
DOUGLAS COUNTY, OREGON

FOUND: 3/4" IRON PIPE., SET BY WEYERHAEUSER ( DATE UNKNOWN )

FROM WHICH:

20" FIR STUMP, SCRIBING VISIBLE, OBT, WEYCO TAG AND "W" NAIL,  
BEARS; N70°E, 33.7 FEET TO FACE.

DECAYED FIR STUMP, SCRIBING VISIBLE,  
BEARS; S75°W, 21.1 FEET TO CENTER.


NEW BTS:

15" FIR STUMP, 48" HIGH, BT TAG,  
BEARS: S 52°E, 18.7 FEET TO 6" SPIKE, PLACED BELOW TAG.

17" FIR STUMP, 60" HIGH, BT TAG,  
BEARS: S 09°W, 11.3.4 FEET TO 6" SPIKE, PLACED BELOW TAG

16" FIR STUMP, 60" HIGH, BT TAG,  
BEARS: N 25°W, 6.9 FEET TO 6" SPIKE, PLACED BELOW TAG

SE 2-25-9.DOC

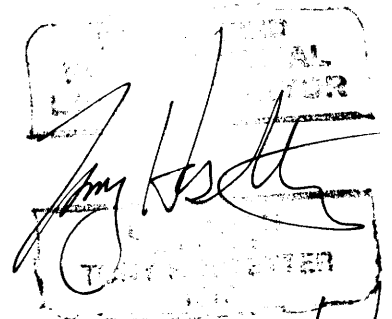

EXPIRES: 6/30/17

C.S. File No 65/89-66