

FS INDEX ID: C-2

CORNER INVESTIGATION REPORT

CORNER: CW 1/16
TOWNSHIP: 31 S
RANGE: 1 W
SECTION: 6
MERIDIAN: W.M.

GCDB ID: 120640
STATE: OREGON
COUNTY: DOUGLAS
FOREST: UMPQUA
DISTRICT: TILLER

DATE: 5/18/2015

HISTORY OF VISITATIONS:

1967-G.S. BAUGHMAN, M34-23, CS 55/41
1979-KURT WEAVER, M81-28, CS 58/216
1980-L.E. HERZSTEIN, CS 61/11

NFSL PROPERTY BOUNDARY CORNER?: YES NO

LINE(S) POSTED: EAST-1967 WEST-1967
MAINTAINED: EAST-2015 WEST-2015
GUARD POST(S): EAST-NONE WEST-3.2 FT

CORNER HISTORY:


(1967)-ESTABLISHES CW1/16, SETS BRASS CAP/IRON PIPE & 2 BT'S.
(1979)-FINDS BRASS CAP/IRON PIPE & 2BT'S.
(1980)-FINDS BRASS CAP/IRON PIPE LEANING & FACING EAST & 2BT'S. RESETS MONUMENT WITH CAP FACING NORTH.

MONUMENT FOUND/SET:

FOUND A 2-1/2" BRASS CAP ON 2-1/2" GALVANIZED IRON PIPE, PROJECTING 5 INCHES ABOVE THE GROUND.

RECORD CORNER ACCESSORIES:

A 8" CEDAR BEARS, N62°30'E - 15.3 FT, WITH A HEALED SINGLE BLAZE THAT POINTS SOUTH & NOT AT CORNER.
A 8" CEDAR BEARS, S70°45'E - 22.3 FT, WITH A HEALED SINGLE BLAZE.

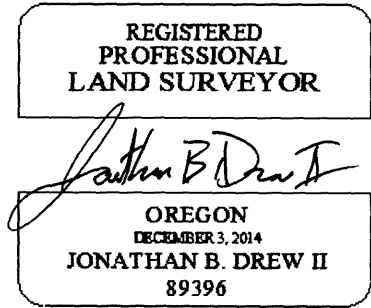

RECORD MEASUREMENTS:

(N64°E-15.4')1967, (N62°18'E-15.4')1980
(S70°E-22.6')1967, (S70°42'E-22.6')1980

NEW CORNER ACCESSORIES:

A 11" CEDAR BEARS, N28°15'E-17.0 FT, MARKED "CW1/16 S6 BT" ON A SINGLE BLAZE. THIS BT WAS MARKED IN 2008 BY A USFS CREW, NO RECORD COULD BE LOCATED AT DCSO OR WITH USFS, IT HAS AN OPEN FACE & SHOWS NO HEALING AT THIS TIME. I PLACE MY WASHER IN THE FACE & MAKE NEW MEASUREMENTS.

METHOD OF MEASUREMENT:

HOLD BEARING OF N88°55'E(M81-28) ON A STEEL LINE POST EAST ~150 FT. BEARINGS BY KERN DKM-1 TRANSIT, DISTANCES BY STEEL TAPE TO NAIL FOUND SIDE CENTER, BEARINGS TO CENTER.

CORNER MAINTENANCE/OTHER INFO:

CLEAR BRUSH FROM AROUND MONUMENT AND TO BT'S. TIE FLAGGING TO MONUMENT AND GUARD POSTS, PAINT BT FACES & A 6" BAND AT HEAD HEIGHT, ADD NEW NAILS TO EXISTING BT TAGS & ADD NEW TAGS WHERE NEEDED. NEW BT INCLUDES A 3/4" BRASS WASHER STAMPED "OR PLS #89396" NAILED BETWEEN "B" & "T" IN FACE.

GEODETIC COORDINATES:

LATTITUDE: N 42° 54' 33.292"
LONGITUDUE: W 122° 52' 40.213"
ELIPSOID HEIGHT:
DATUM: WGS84

DOCUMENTS ON FILE AT:

3106 PIERCE PARKWAY, STE. D
SPRINGFIELD, OREGON 97477


SOURCE: USGS QUAD MAP, FOR NAVIGATION TO CORNER.

DATE OF INVESTIGATION: 5/13/2015

REPORT BY: JONATHAN B. DREW II, PLS 89396

ASSISTED BY: LANCE GOUCHER, SURVEY TECH.

CAP DIAGRAM:

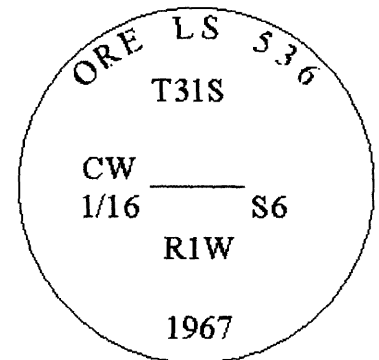

THIS DOCUMENT FILED IN CS OFFICE: YES
OTHER DOCUMENT FILED WITH CS: NONE

C.S. File No 65/90-1