

FS INDEX ID: G-5

CORNER INVESTIGATION REPORT

CORNER: 1/4
TOWNSHIP: 31 S
RANGE: 1 W
SECTION: 7 & 8
MERIDIAN: W.M.
NFSL PROPERTY BOUNDARY CORNER?: YES NO

GCDB ID: 200540
STATE: OREGON
COUNTY: DOUGLAS
FOREST: UMPQUA
DISTRICT: TILLER

DATE: 5/18/2015

HISTORY OF VISITATIONS:
 1857-DENNIS HATHORN, GLO SURVEY
 1960-JOHN MARKHAM JR., CS 51/142
 1977-WILLIAM RUPPERT, M65-60&M65-50
 2000-L.L. FANNING, USFS CORNER CARD
 2003-L.E. HERZSTEIN, BLM RESURVEY


LINE(S) POSTED: EAST-1977 WEST-1977
MAINTAINED: EAST-2015 WEST-2003
GUARD POST(S): EAST-4.0 FT WEST-3.4 FT

CORNER HISTORY:

(1857)-ESTABLISHED 1/4 CORNER, SETS WOOD POST & 2 BT'S.
 (1966)-FINDS 1 BT, SETS STEEL SHAFT & 3 BT'S & 1 ADDITIONAL BT FOUND 1977.
 (1977)-FINDS STEEL SHAFT & 5 BT'S, SETS BRASS CAP/IRON PIPE.
 (2000)-FINDS BRASS CAP/IRON PIPE & 5 BT'S.
 (2003)-FINDS BRASS CAP/IRON PIPE & 5 BT'S.

MONUMENT FOUND/SET:

FOUND A 2-1/2" BRASS CAP ON 2-1/2" GALVANIZED IRON PIPE, PROJECTING 2 INCHES ABOVE A RING OF STONE.

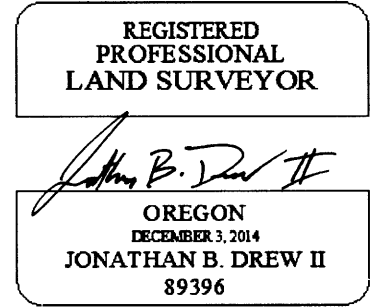

EXPIRES: 12/31/2015
RECORD MEASUREMENTS:

(S32°W - 46.2 FT)1857
 (N35°E-38.9')1857, (N35°E-40.1')2003
 (S46°E - 47.0')1960, (S44°30'E-46.4')2003
 (S53°W - 26.6')1960, (S54°W - 22.0')2003
 NO ORIGINAL, (N87°30'W-32.7')2003
 (N8°W-71.5')1960, (N7°15'W-71.3')2003

RECORD CORNER ACCESSORIES:

NO TRACE FOUND OF A (12" FIR)1857
 A 28" PINE SNAG WITH SCRIBE VISIBLE ON A PREVIOUSLY OPENED DOUBLE BLAZE.
 A 32" PINE WITH SCRIBE VISIBLE ON A PART. HEALED UPPER BLAZE, HEALED LOWER BLAZE
 A 21" FIR WITH A HEALED DOUBLE BLAZE, LEANS HEAVY WEST.
 A 26" FIR WITH A HEALED SINGLE BLAZE & "B" BARK SCRIBE VISIBLE BELOW.
 A 16" OAK WITH A HEALED DOUBLE BLAZE.

NEW CORNER ACCESSORIES:

NO NEW ACCESSORIES NEEDED.

METHOD OF MEASUREMENT:


NO NEW MEASUREMENTS TAKEN.

FILED AS CONDITION REPORT.

CORNER MAINTENANCE/OTHER INFO:

CLEAR BRUSH FROM AROUND MONUMENT AND TO BT'S. TIE FLAGGING TO MONUMENT AND GUARD POSTS, PAINT BT FACES & A 6" BAND AT HEAD HEIGHT, ADD NEW NAILS TO EXISTING BT TAGS & ADD NEW TAGS WHERE NEEDED.

CAP DIAGRAM:

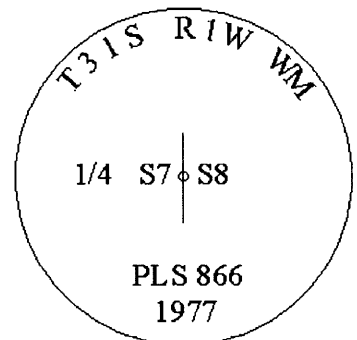

GEODETTIC COORDINATES:

LATTITUDE: N 42° 53' 41.044"
 LONGITUDUE: W 122° 51' 48.878"
 ELIPSOID HEIGHT:
 DATUM: WGS 84

DOCUMENTS ON FILE AT:

3106 PIERCE PARKWAY, STE. D
 SPRINGFIELD, OREGON 97477

SOURCE: USGS QUAD MAP, FOR NAVIGATION TO CORNER.

DATE OF INVESTIGATION: 4/28/15

REPORT BY: JONATHAN B. DREW II, PLS 89396

ASSISTED BY: LANCE GOUCHER, SURVEY TECH.

THIS DOCUMENT FILED IN CS OFFICE: YES
OTHER DOCUMENT FILED WITH CS: NONE

C.S. File No 65/90-3