

FS INDEX ID: G-8

CORNER INVESTIGATION REPORT

CORNER: CE 1/16 GCDB ID: 260540
TOWNSHIP: 31 S STATE: OREGON
RANGE: 1 W COUNTY: DOUGLAS
SECTION: 8 FOREST: UMPQUA
MERIDIAN: W.M. DISTRICT: TILLER
NFSL PROPERTY BOUNDARY CORNER?: YES NO


DATE: 6/1/2015

HISTORY OF VISITATIONS:
 1977-WILLIAM J. RUPPERT, M65-50
 2000-LES FANNING, CS 65/36-7

LINE(S) POSTED: SOUTH-1977 NORTH-1977
MAINTAINED: SOUTH-2015 NORTH-2000
GUARD POST(S): SOUTH-6.7 FT NORTH-3.8 FT
CORNER HISTORY:

(1977)-ESTABLISHES CE 1/16 SECTION 8, SETS BRASS CAP/IRON PIPE & 2 BT'S.
 (2001)-FINDS BRASS CAP/IRON PIPE & 2 BT'S.

**REGISTERED
PROFESSIONAL
LAND SURVEYOR**

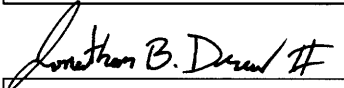

**OREGON
DECEMBER 3, 2014
JONATHAN B. DREW II
89396**

MONUMENT FOUND/SET:

FOUND A 2-1/2" BRASS CAP ON 2-1/2" GALVANIZED IRON PIPE, PROJECTING 2 INCHES IN A LARGE MOUND OF STONE.

EXPIRES: 12/31/2015
RECORD MEASUREMENTS:
 (S63°W - 22.3 FT)1977
 (S71°20'E - 66.7 FT)1977, (67.5 FT)2000

RECORD CORNER ACCESSORIES:

A 29" FIR WITH A HEALED DOUBLE BLAZE.
 A 32" FIR WITH A HEALED DOUBLE BLAZE.

NEW CORNER ACCESSORIES:

NO NEW ACCESSORIES NEEDED.


METHOD OF MEASUREMENT:
 NO NEW MEASUREMENTS TAKEN.

 FILED AS CONDITION REPORT.

CORNER MAINTENANCE/OTHER INFO:

CLEAR BRUSH FROM AROUND MONUMENT AND TO BT'S. TIE FLAGGING TO MONUMENT AND GUARD POSTS, PAINT BT FACES & A 6" BAND AT HEAD HEIGHT, ADD NEW NAILS TO EXISTING BT TAGS & ADD NEW TAGS WHERE NEEDED.

CAP DIAGRAM:

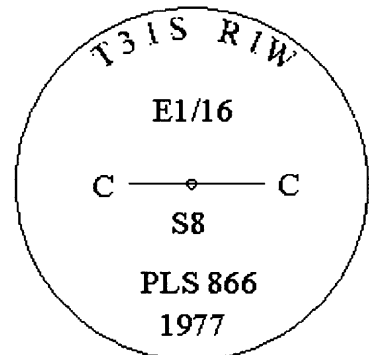

GEODETTIC COORDINATES:

LATTITUDE: N 42° 53' 40.492"
 LONGITUDUE: W 122° 50' 54.612"
 ELIPSOID HEIGHT: 3460 FT
 DATUM: WGS84

DOCUMENTS ON FILE AT:

3106 PIERCE PARKWAY, STE. D
 SPRINGFIELD, OREGON 97477

SOURCE: USGS QUAD MAP, FOR NAVIGATION TO CORNER.

DATE OF INVESTIGATION: 4/29/2015

REPORT BY: JONATHAN B. DREW II, PLS 89396

ASSISTED BY: LANCE GOUCHER, SURVEY TECH.

THIS DOCUMENT FILED IN CS OFFICE: YES
OTHER DOCUMENT FILED WITH CS: NONE

C.S. File No 65/90-5