

CORNER INVESTIGATION REPORT

FS INDEX ID: H-3

CORNER: CS 1/16
TOWNSHIP: 31 S
RANGE: 1 W
SECTION: 7
MERIDIAN: W.M.
GCDB ID: 140520
STATE: OREGON
COUNTY: DOUGLAS
FOREST: UMPQUA
DISTRICT: TILLER
NFSL PROPERTY BOUNDARY CORNER?: [x] YES [] NO

DATE: 4/24/2015

HISTORY OF VISITATIONS:
1977-WILLIAM J. RUPPERT, M65-60
1984-LEONARD HERZSTEIN, CS 62/15-19

LINE(S) POSTED: EAST-1977 SOUTH-1977
MAINTAINED: EAST-2015 SOUTH-2015
GUARD POST(S): EAST-4.0 FT SOUTH-4.0 FT

CORNER HISTORY:
(1977)-ESTABLISHES THE CS1/16 CORNER, SETS BRASS CAP/IRON PIPE & 3 BT'S.
(1984)-FINDS BRASS CAP/IRON PIPE & 3 BT'S

MONUMENT FOUND/SET:
FOUND A 2-1/2" BRASS CAP ON 2-1/2" GALVANIZED IRON PIPE, PROJECTING 4 INCHES ABOVE A MOUND OF STONE.


RECORD CORNER ACCESSORIES:
A 11" FIR WITH A HEALED DOUBLE BLAZE.
A 17" FIR WITH A HEALED DOUBLE BLAZE. (BLAZE FACING FOR S80°E BT)1984
A 27" PINE WITH A HEALED DOUBLE BLAZE. (BLAZE FACING FOR S28°W BT)1984
(RECORD 17" FIR)1977, (RECORD 17" PINE)1984

NEW CORNER ACCESSORIES:
NO NEW ACCESSORIES NEEDED.

CORNER MAINTENANCE/OTHER INFO:
CLEAR BRUSH FROM AROUND MONUMENT AND TO BT'S. TIE FLAGGING TO MONUMENT AND GUARD POSTS, PAINT BT FACES & A 6" BAND AT HEAD HEIGHT, ADD NEW NAILS TO EXISTING BT TAGS & ADD NEW TAGS WHERE NEEDED.

GEODETTIC COORDINATES:
LATTITUDE: N42°53'27.565"
LONGITUDUE: W122°52'24.308"
ELIPSOID HEIGHT:
DATUM: WGS 84
SOURCE: USGS QUAD MAP, FOR NAVIGATION TO CORNER.
DATE OF INVESTIGATION: 4/21/2015
REPORT BY: JONATHAN B. DREW II, PLS 89396
ASSISTED BY: LANCE GOUCHER, SURVEY TECH.

DOCUMENTS ON FILE AT:
3106 PIERCE PARKWAY, STE. D
SPRINGFIELD, OREGON 97477

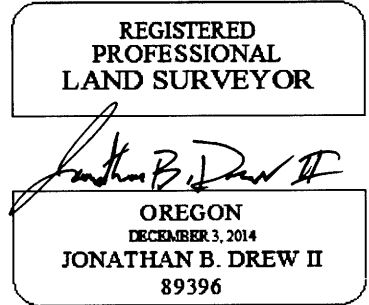


EXPIRES: 12/31/2015
RECORD MEASUREMENTS:
(N78°30'W - 4.5 FT)1977 & 1984
(S25°50'E - 12.6 FT)1977 & 1984
(S59°20'W - 60.7 FT)1977 & 1984

METHOD OF MEASUREMENT:
NO NEW MEASUREMENTS TAKEN.

FILED AS A CONDITION REPORT.

CAP DIAGRAM:

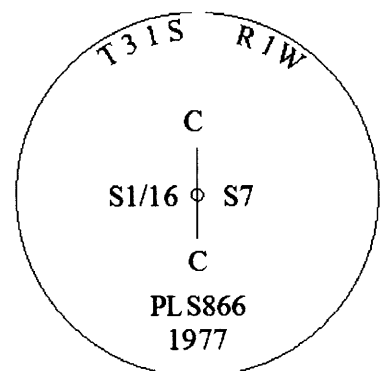

THIS DOCUMENT FILED IN CS OFFICE: YES
OTHER DOCUMENT FILED WITH CS: NONE

C.S. File No 65190-6