

FS INDEX ID: H-5

CORNER INVESTIGATION REPORT

CORNER: S 1/16
TOWNSHIP: 31 S
RANGE: 1 W
SECTION: 7 & 8
MERIDIAN: W.M.

GCDB ID: 200520
STATE: OREGON
COUNTY: DOUGLAS
FOREST: UMPQUA
DISTRICT: TILLER

DATE: 4/23/2015

HISTORY OF VISITATIONS:

1977-WILLIAM RUPPERT, M65-60&M65-50
2000-L.L. FANNING, USFS CORNER CARD

NFSL PROPERTY BOUNDARY CORNER?: YES NO

LINE(S) POSTED: WEST-1977 SOUTH-1977

MAINTAINED: WEST-2015 SOUTH-2015

GUARD POST(S): WEST-5.0 FT SOUTH-3.9 FT

CORNER HISTORY:

(1977)-ESTABLISHES THE S1/16 CORNER, SETS BRASS CAP/IRON PIPE & 2 BT'S.
(2001)-FINDS BRASS CAP/IRON PIPE & 2 BT'S.

MONUMENT FOUND/SET:

FOUND A 2-1/2" BRASS CAP ON 2-1/2" GALVANIZED IRON PIPE, PROJECTING 1 INCH ABOVE A RING OF STONE.

RECORD CORNER ACCESSORIES:

A 32" FIR WITH A HEALED DOUBLE BLAZE.
A 15" FIR WITH A HEALED DOUBLE BLAZE.

NEW CORNER ACCESSORIES:

NO NEW ACCESSORIES NEEDED.

CORNER MAINTENANCE/OTHER INFO:

CLEAR BRUSH FROM AROUND MONUMENT AND TO BT'S. TIE FLAGGING TO MONUMENT AND GUARD POSTS, PAINT BT FACES & A 6" BAND AT HEAD HEIGHT, ADD NEW NAILS TO EXISTING BT TAGS & ADD NEW TAGS WHERE NEEDED.

GEODETTIC COORDINATES:

LATTITUDE: N42°53'27.677"
LONGITUDUE: W122°51'48.725"
ELIPSOID HEIGHT:
DATUM: WGS 84

SOURCE: USGS QUAD MAP, FOR NAVIGATION TO CORNER.


DATE OF INVESTIGATION: 4/21/2015

REPORT BY: JONATHAN B. DREW II, PLS 89396

ASSISTED BY: LANCE GOUCHER, SURVEY TECH.

DOCUMENTS ON FILE AT:

3106 PIERCE PARKWAY, STE. D
SPRINGFIELD, OREGON 97477

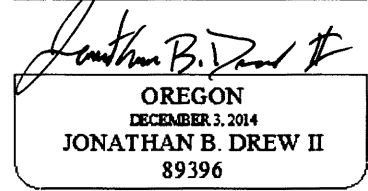

EXPIRES: 12/31/2015

RECORD MEASUREMENTS:


(N24°36'W - 18.3 FT)1977
(N56°31'E - 11.8 FT)1977

METHOD OF MEASUREMENT:

NO NEW MEASUREMENTS TAKEN.

FILED AS CONDITION REPORT.

CAP DIAGRAM:

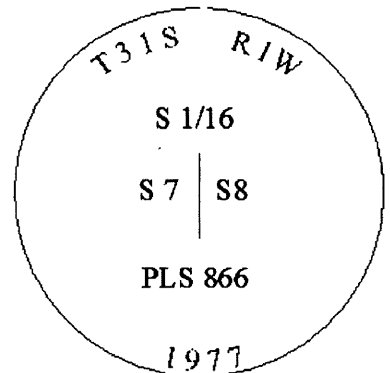

THIS DOCUMENT FILED IN CS OFFICE: YES
OTHER DOCUMENT FILED WITH CS: NONE

C.S. File No 65/90-7