

FS INDEX ID: H-8

CORNER INVESTIGATION REPORT

CORNER: SE 1/16
TOWNSHIP: 31 S
RANGE: 1 W
SECTION: 8
MERIDIAN: W.M.
NFSL PROPERTY BOUNDARY CORNER?: YES NO

GCDB ID: 260520
STATE: OREGON
COUNTY: DOUGLAS
FOREST: UMPQUA
DISTRICT: TILLER

DATE: 6/1/2015

HISTORY OF VISITATIONS:
 1977-WILLIAM J. RUPPERT, M65-50
 2000-L.L. FANNING, USFS CORNER CARD

LINE(S) POSTED: NORTH-1977 EAST-1977
MAINTAINED: NORTH-2015 EAST-2015
GUARD POST(S): NORTH-4.1 FT EAST-3.9 FT
CORNER HISTORY:

(1977)-ESTABLISHES SE 1/16 SECTION 8, SETS BRASS CAP/IRON PIPE & 2 BT'S.
 (2000)-FINDS BRASS CAP/IRON PIPE & 2 BT'S.

MONUMENT FOUND/SET:

FOUND A 2-1/2" BRASS CAP ON 2-1/2" GALVANIZED IRON PIPE, PROJECTING 2 INCHES ABOVE A MOUND OF STONE.

RECORD CORNER ACCESSORIES:

A 28" FIR WITH A HEALED DOUBLE BLAZE.
 A 24" FIR WITH A HEALED DOUBLE BLAZE.

NEW CORNER ACCESSORIES:

NO NEW ACCESSORIES NEEDED.

CORNER MAINTENANCE/OTHER INFO:

CLEAR BRUSH FROM AROUND MONUMENT AND TO BT'S. TIE FLAGGING TO MONUMENT AND GUARD POSTS, PAINT BT FACES & A 6" BAND AT HEAD HEIGHT, ADD NEW NAILS TO EXISTING BT TAGS & ADD NEW TAGS WHERE NEEDED.


GEODETIC COORDINATES:

LATTITUDE: N 42° 53' 27.567
 LONGITUDUE: W 122° 50' 54.510"
 ELIPSOID HEIGHT: 3010 FT
 DATUM: WGS84

DOCUMENTS ON FILE AT:

3106 PIERCE PARKWAY, STE. D
 SPRINGFIELD, OREGON 97477

SOURCE: USGS QUAD MAP. FOR NAVIGATION TO CORNER
DATE OF INVESTIGATION: 4/29/2015
REPORT BY: JONATHAN B. DREW II, PLS 89396
ASSISTED BY: LANCE GOUCHER, SURVEY TECH.

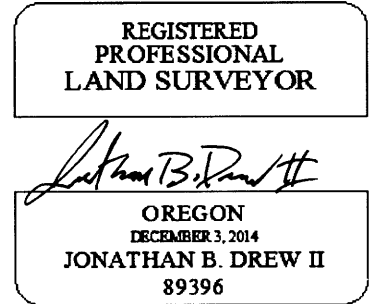


EXPIRES: 12/31/2015
RECORD MEASUREMENTS:
 (N16°37'W - 64.7 FT)1977
 (S66°42'E - 29.5 FT)1977

METHOD OF MEASUREMENT:
NO NEW MEASUREMENTS TAKEN.

FILED AS CONDITION REPORT.

CAP DIAGRAM:

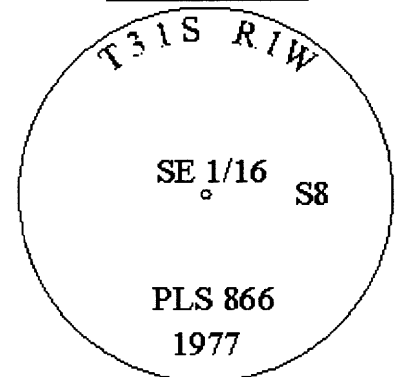

THIS DOCUMENT FILED IN CS OFFICE: YES
OTHER DOCUMENT FILED WITH CS: NONE

C.S. File No 65/90-8