

FS INDEX ID: J-13

CORNER INVESTIGATION REPORT

CORNER: SECTION GCDB ID: 400502 DATE: 6/1/2015
TOWNSHIP: 31S STATE: OREGON
RANGE: 1W COUNTY: DOUGLAS
SECTION: 9 & 16 ONLY FOREST: UMPQUA
MERIDIAN: W.M. DISTRICT: TILLER
NFSL PROPERTY BOUNDARY CORNER?: [x] YES [] NO

HISTORY OF VISITATIONS:
1857-D. HATHORN, GLO SURVEY
1922-F. MENSCH, GLO RESURVEY
1968-J.M. POWELL ET. AL., CS 54/71
1979-G.S. BAUGHMAN, USFS COR CARD
1986-L.R. MOFFIT, USFS CORNER CARD


LINE(S) POSTED: SOUTH-1979 WEST-1979
MAINTAINED: SOUTH-2015 WEST-1986
GUARD POST(S): SOUTH-3.2 FT WEST-2.3 FT

CORNER HISTORY:

(1857)-ESTABLISHED SECTION CORNER, SETS POST & 4 BT'S.
(1922)-FINDS 4 BT'S, SETS BRASS CAP/IRON PIPE & 1 NEW BT, OBLITERATE MARKS
REFERRING TO SECS. 10 & 15, MAKES CORNER OF MINIMUM CONTROL.
(1968)-FINDS BRASS CAP/IRON PIPE & 2 BT'S, SETS 1 NEW BT.
(1979 & 1986)-FINDS BRASS CAP/IRON PIPE & 3 BT'S.

MONUMENT FOUND/SET:

FOUND 2-1/2" GLO BRASS CAP ON 2" IRON PIPE, PROJECTING 12 INCHES ABOVE A
MOUND OF STONE. 1 PAINT IRON PIPE RED TO PROTECT FROM RUSTING FURTHER.

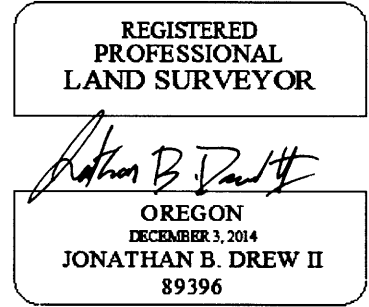

EXPIRES: 12/31/2015

RECORD CORNER ACCESSORIES:

NO TRACE FOUND OF A (15" FIR)1857
AN INDETERMINATE SIZE FIR STUB BEARS, S17°15'E - 73.2 FT WITH SCRIBE "BT"
VISIBLE ON AN EXPOSED FACE.
A 37" FIR BEARS, N1°30'W - 41.0 FT, WITH A HEALED SINGLE BLAZE.
AN INDETERMINATE SIZE FIR SHELL BEARS, N8°E - 38.9 FT, WITH NO MARKS VISIBLE.
NO TRACE FOUND OF A (20" FIR)1922
A 31" FIR BEARS, S89°30'W - 5.7 FT, WITH A HEALED SINGLE BLAZE.

RECORD MEASUREMENTS:

(S70°W-27.7 FT)1857
(S20°E-66.0 FT)1857 & 1922
(N1°W-39.6 FT)1857 & 1922 & 1968
(N8°E-38.3 FT)1857 & 1922
(S51°W-30.4 FT)1922 & 1968
(S89°30'W-5.7 FT)1968

NEW CORNER ACCESSORIES:

A 6" FIR BEARS, N70°45'E - 40.9 FT, MARKED "X" "BT" ON A DOUBLE BLAZE.

METHOD OF MEASUREMENT:

KERN DKMI TRANSIT & STEEL TAPE,
HOLD S0°12'W ON GLO BRASS CAP
FOR CLOSING CORNER S 10&15.
DISTANCES TO NAIL SET SIDE
CENTER, BEARINGS TO CENTER
CC S10/15 BEARS, S0°12'W - 128.8 FT.
1922 GLO RECORD (S0°12'W-129.36 FT)

CORNER MAINTENANCE/OTHER INFO:

CLEAR BRUSH FROM AROUND MONUMENT AND TO BT'S. TIE FLAGGING TO
MONUMENT AND GUARD POSTS, PAINT BT FACES & A 6" BAND AT HEAD HEIGHT,
ADD NEW NAILS TO EXISTING BT TAGS & ADD NEW TAGS WHERE NEEDED.
ACCESSORIES MEASURED TO NEAREST 1/4° TO CENTER & 0.1 FT TO SIDE CENTER.
NEW BT INCLUDES A 3/4" BRASS WASHER STAMPED "ORPLS #89396" BETWEEN B&T.


GEODETIC COORDINATES:

LATTITUDE: N 42° 53' 13.344"
LONGITUDUE: W 122° 49' 25.321"
ELIPSOID HEIGHT: 4035 FT
DATUM: WGS 84

DOCUMENTS ON FILE AT:

3106 PIERCE PARKWAY, STE. D
SPRINGFIELD, OREGON 97477

CAP DIAGRAM:

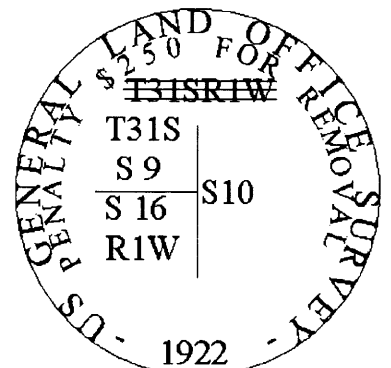

SOURCE: CELL PHONE GPS, FOR NAVIGATION TO CORNER.

DATE OF INVESTIGATION: 5/4/2015

REPORT BY: JONATHAN B. DREW II, PLS 89396

ASSISTED BY: LANCE GOUCHER, SURVEY TECH.
ANDREW HILLMAN, SURVEY TECH

THIS DOCUMENT FILED IN CS OFFICE: YES
OTHER DOCUMENT FILED WITH CS: NONE

C.S. File No 65/90-12