

FS INDEX ID: K-5

CORNER INVESTIGATION REPORT

CORNER: N 1/16
TOWNSHIP: 31 S
RANGE: 1 W
SECTION: 18 & 17
MERIDIAN: W.M.
NFSL PROPERTY BOUNDARY CORNER?: YES NO

GCDB ID: 200460
STATE: OREGON
COUNTY: DOUGLAS
FOREST: UMPQUA
DISTRICT: TILLER

DATE: 4/24/2015

HISTORY OF VISITATIONS:
 1972-J.A. HOFFBUHR, M42-75 & M42-80

LINE(S) POSTED: WEST-1972 SOUTH-1972
MAINTAINED: WEST-2015 SOUTH-2015
GUARD POST(S): WEST-4.3 FT SOUTH-0.2 FT

CORNER HISTORY:

(1972)-ESTABLISHES THE N1/16 CORNER, SETS BRASS CAP/IRON PIPE & 2 BT'S.

MONUMENT FOUND/SET:

FOUND A 3" BRASS CAP ON 2-1/2" GALVANIZED IRON PIPE, FLUSH WITH GROUND.

RECORD CORNER ACCESSORIES:

A 17" FIR WITH A BROKEN TOP AND HEALED DOUBLE BLAZE.
 A 21" FIR WITH A HEALED DOUBLE BLAZE.

NEW CORNER ACCESSORIES:

NO NEW ACCESSORIES NEEDED, BROKEN TOP FIR HAS SEVERAL LARGE LIVE LIMBS AND SHOULD SURVIVE FOR SOME TIME.

CORNER MAINTENANCE/OTHER INFO:

CLEAR BRUSH FROM AROUND MONUMENT AND TO BT'S. TIE FLAGGING TO MONUMENT AND GUARD POSTS, PAINT BT FACES & A 6" BAND AT HEAD HEIGHT, ADD NEW NAILS TO EXISTING BT TAGS & ADD NEW TAGS WHERE NEEDED.

GEODETIC COORDINATES:

LATTITUDE: N42°53'01.346"
LONGITUDUE: W122°51'48.556"
ELIPSOID HEIGHT:
DATUM: WGS 84

DOCUMENTS ON FILE AT:


3106 PIERCE PARKWAY, STE. D
 SPRINGFIELD, OREGON 97477

SOURCE: USGS QUAD MAP, FOR NAVIGATION TO CORNER.

DATE OF INVESTIGATION: 4/20/2015

REPORT BY: JONATHAN B. DREW II, PLS 89396


ASSISTED BY: LANCE GOUCHER, SURVEY TECH.

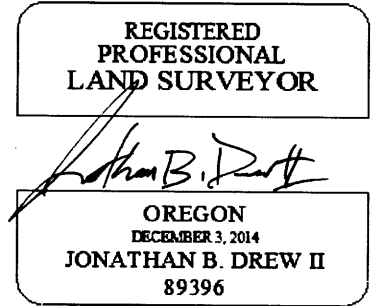

EXPIRES: 12/31/2015
RECORD MEASUREMENTS:
 (S31°30'E - 36.3 FT)1972
 (S65°W - 45.3 FT)1972

METHOD OF MEASUREMENT:
 NO NEW MEASUREMENTS TAKEN.
 FILED AS A CONDITION REPORT.

CAP DIAGRAM:

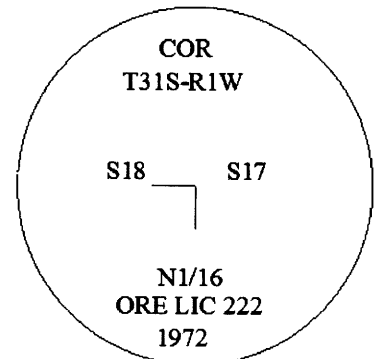

THIS DOCUMENT FILED IN CS OFFICE: YES
OTHER DOCUMENT FILED WITH CS: NONE

C.S. File No 65/90-14