

FS INDEX ID: L-5

CORNER INVESTIGATION REPORT

CORNER: 1/4 GCDB ID: 200440 DATE: 4/24/2015
TOWNSHIP: 31 S STATE: OREGON
RANGE: 1 W COUNTY: DOUGLAS
SECTION: 18 & 17 FOREST: UMPQUA
MERIDIAN: W.M. DISTRICT: TILLER
NFSL PROPERTY BOUNDARY CORNER?: [x] YES [ ] NO

LINE(S) POSTED: NORTH-1972 EAST-1972
MAINTAINED: NORTH-2015 EAST-2014
GUARD POST(S): NORTH-2.2 FT EAST 1.5 FT

CORNER HISTORY:

- (1857)-ESTABLISHES 1/4 CORNER, SETS POST & 2 BT'S.
(1968)-FINDS REMAINS OF 2 BT STUMPS, SETS BRASS CAP/IRON POST & 2 BT'S.
(1972)-POSTS NFSL PROPERTY LINES, TIES CORNER BUT DESCRIPTION PROVIDED ON PLAT M42-75 IS NOT FOR THIS CORNER.
(2014)-MAINTAINS CORNER & LINE EAST, FINDS BRASS CAP/IRON PIPE & 2 BT'S.
MONUMENT FOUND/SET:

FOUND A 2-1/2" DCSO BRASS CAP ON 1-1/4" GALVANIZED IRON PIPE, PROJECTING 7 INCHES ABOVE A SMALL MOUND OF STONES. LEANS SLIGHTLY SOUTH.
NOTE: "1/4" AND SECTION NUMBER MARKINGS ORIENTED NORTH, ALL OTHERS ARE NOT, AS SHOWN BELOW.

RECORD CORNER ACCESSORIES:

- A 14" CEDAR WITH A HEALED DOUBLE BLAZE.
A 22" FIR WITH A HEALED DOUBLE BLAZE.

NEW CORNER ACCESSORIES:

NO NEW ACCESSORIES NEEDED.

CORNER MAINTENANCE/OTHER INFO:

CLEAR BRUSH FROM AROUND MONUMENT AND TO BT'S. TIE FLAGGING TO MONUMENT AND GUARD POSTS, PAINT BT FACES & A 6" BAND AT HEAD HEIGHT, ADD NEW NAILS TO EXISTING BT TAGS & ADD NEW TAGS WHERE NEEDED.

GEODETIC COORDINATES:

LATTITUDE: N42°52'48.377"
LONGITUDUE: W122°51'48.653"
ELIPSOID HEIGHT:
DATUM: WGS 84

SOURCE: USGS QUAD MAP, FOR NAVIGATION TO CORNER.

DATE OF INVESTIGATION: 4/20/2015


REPORT BY: JONATHAN B. DREW II, PLS 89396

ASSISTED BY: LANCE GOUCHER, SURVEY TECH.

DOCUMENTS ON FILE AT:

3106 PIERCE PARKWAY, STE. D
SPRINGFIELD, OREGON 97477

HISTORY OF VISITATIONS:
1857-DENNIS HATHORN, GLO SURVEY
1968-JOHN POWELL, ET. AL., CS 54/71
1972-J.A. HOFFBUHR, M42-75 & M42-80
2014-JONATHAN DREW II, USFS CORNER CARD

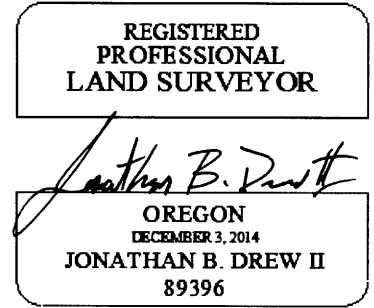

EXPIRES: 12/31/2015

RECORD MEASUREMENTS:


- (N40°W-22.0 FT)1968
(N67°E-28.3 FT)1968

METHOD OF MEASUREMENT:

NO NEW MEASUREMENTS TAKEN.

FILED AS CONDITION REPORT.

CAP DIAGRAM:

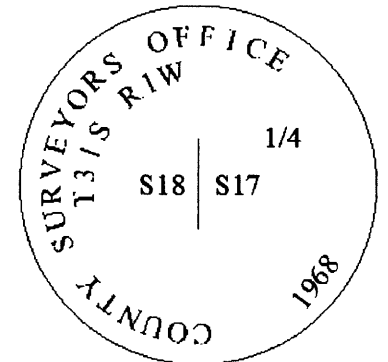

THIS DOCUMENT FILED IN CS OFFICE: YES
OTHER DOCUMENT FILED WITH CS: NONE

C.S. File No T31S/90-15