

FS INDEX ID: L.07-13

# CORNER INVESTIGATION REPORT

CORNER: 1/4  
TOWNSHIP: 31S  
RANGE: 1W  
SECTION: 15 ONLY  
MERIDIAN: W.M.  
NFSL PROPERTY BOUNDARY CORNER?:  YES  NO  
LINE(S) POSTED: SOUTH-1979 NORTH-1979  
MAINTAINED: SOUTH-1986 NORTH-2015  
GUARD POST(S): SOUTH-2.9 FT NORTH-NONE

GCDB ID: 400440  
STATE: OREGON  
COUNTY: DOUGLAS  
FOREST: UMPQUA  
DISTRICT: TILLER


DATE: 6/1/2015

HISTORY OF VISITATIONS:

1922-F. MENSCH, GLO SURVEY  
 1968-J.M. POWELL, CS 54/71  
 1979-G.S. BAUGHMAN, USFS COR CARD  
 1986-L.R. MOFFIT, USFS CORNER CARD

CORNER HISTORY:

(1922)-ESTABLISHED 1/4 CORNER BY PROPORTION SETS BRASS CAP/I.P.I.PE & 2 BT'S.  
 (1968,1979 & 1986)-FINDS BRASS CAP/IRON PIPE & 2 BTS.

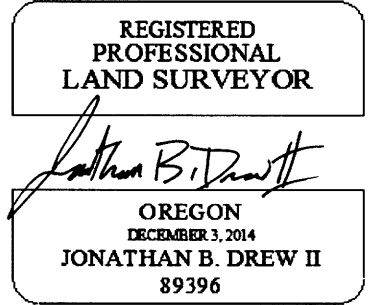

MONUMENT FOUND/SET:

FOUND 2-1/2" GLO BRASS CAP ON 1" IRON PIPE, PROJECTING 4 INCHES ABOVE A MOUND OF STONE. 1 PAINT IRON PIPE RED TO PROTECT FROM RUSTING FURTHER.

EXPIRES: 12/31/2015

RECORD CORNER ACCESSORIES:

A 47" FIR WITH A HEALED SINGLE BLAZE.  
 A 27" FIR WITH A HEALED SINGLE BLAZE.

RECORD MEASUREMENTS:

(N40°E-44.2 FT)1922  
 (S53°E- 29.0 FT)1922

NEW CORNER ACCESSORIES:

NO NEW ACCESSORIES NEEDED.

METHOD OF MEASUREMENT:

NO NEW MEASUREMENTS TAKEN.

CORNER MAINTENANCE/OTHER INFO:

CLEAR BRUSH FROM AROUND MONUMENT AND TO BT'S. TIE FLAGGING TO MONUMENT AND GUARD POSTS, PAINT BT FACES & A 6" BAND AT HEAD HEIGHT, ADD NEW NAILS TO EXISTING BT TAGS & ADD NEW TAGS WHERE NEEDED.

FILED AS CONDITION REPORT.

GEODETTIC COORDINATES:

LATTITUDE: N 42° 52' 46.199"  
 LONGITUDUE: W 122° 49' 25.495"  
 ELIPSOID HEIGHT: 3985 FT  
 DATUM: WGS 84

DOCUMENTS ON FILE AT:

3106 PIERCE PARKWAY, STE. D  
 SPRINGFIELD, OREGON 97477

SOURCE: CELL PHONE GPS, FOR NAVIGATION TO CORNER.

DATE OF INVESTIGATION: 5/4/2015

REPORT BY: JONATHAN B. DREW II, PLS 89396

ASSISTED BY:

CAP DIAGRAM:



THIS DOCUMENT FILED IN CS OFFICE: YES  
OTHER DOCUMENT FILED WITH CS: NONE

CS File No 65190-16