

FS INDEX ID: L-13

CORNER INVESTIGATION REPORT

CORNER: 1/4
TOWNSHIP: 31S
RANGE: 1W
SECTION: 16 ONLY
MERIDIAN: W.M.
GCDB ID: 400441
STATE: OREGON
COUNTY: DOUGLAS
FOREST: UMPQUA
DISTRICT: TILLER
NFSL PROPERTY BOUNDARY CORNER?: [x] YES [] NO

LINE(S) POSTED: SOUTH-1979 NORTH-1979
MAINTAINED: SOUTH-2015 NORTH-2015
GUARD POST(S): SOUTH-5.7 FT NORTH-3.6 FT

CORNER HISTORY:

- (1857)-ESTABLISHED 1/4 CORNER, SETS POST & 2 BT'S.
(1922)-FINDS NO EVIDENCE, SETS BRASS CAP/IRON PIPE BY PROPORTION & 2 BT'S.
(1968)-FINDS BRASS CAP/IRON PIPE & 2 BTS, SETS 2 NEW BTS.
(1979)-FINDS BRASS CAP/IRON PIPE & 4 BT'S.
(1986)-FINDS BC/IP & 4 BT'S, BUILDS ROCK MOUND, NOTES CAP FACES SOUTH.

MONUMENT FOUND/SET:

FOUND 2-1/2" GLO BRASS CAP ON 1" IRON PIPE, PROJECTING 7 INCHES ABOVE A MOUND OF STONE. 1 PAINT IRON PIPE RED TO PROTECT FROM RUSTING FURTHER. CAP MARKINGS ARE FACEING SOUTH AS SHOWN BELOW.

RECORD CORNER ACCESSORIES:

- NO TRACE FOUND OF A (36" FIR)1857
NO TRACE FOUND OF A (12" FIR)1857
AN INDETERMINATE SIZE FIR STUMP WITH A HEALED FACE & AX WORK VISIBLE.
AN INDETERMINATE SIZE FIR STUMP WITH A NO MARKS VISIBLE.
A 24" TRIPLE TOP FIR WITH A HEALED DOUBLE BLAZE.
A 14" FIR WITH A HEALED DOUBLE BLAZE.
A 2-1/2" BRASS CAP ON 1" IRON PIPE, THE 1/4 CORNER FOR SECTION 15 ONLY

NEW CORNER ACCESSORIES:

NO NEW ACCESSORIES NEEDED.

CORNER MAINTENANCE/OTHER INFO:

CLEAR BRUSH FROM AROUND MONUMENT AND TO BT'S. TIE FLAGGING TO MONUMENT AND GUARD POSTS, PAINT BT FACES & A 6" BAND AT HEAD HEIGHT, ADD NEW NAILS TO EXISTING BT TAGS & ADD NEW TAGS WHERE NEEDED.

GEODETC COORDINATES:

LATTITUDE: N 42° 52' 46.870"
LONGITUDUE: W 122° 49' 25.614"
ELIPSOID HEIGHT: 4000 FT
DATUM: WGS 84

SOURCE: CELL PHONE GPS, FOR NAVIGATION TO CORNER.

DATE OF INVESTIGATION: 5/4/2015


REPORT BY: JONATHAN B. DREW II, PLS 89396

ASSISTED BY:

DOCUMENTS ON FILE AT:

3106 PIERCE PARKWAY, STE. D
SPRINGFIELD, OREGON 97477

HISTORY OF VISITATIONS:
1857-D. HATHORN, GLO SURVEY
1922-F. MENSCH, GLO RESURVEY
1968-J.M. POWELL, CS 54/71
1979-G.S. BAUGHMAN, USFS COR CARD
1986-L.R. MOFFIT, USFS CORNER CARD

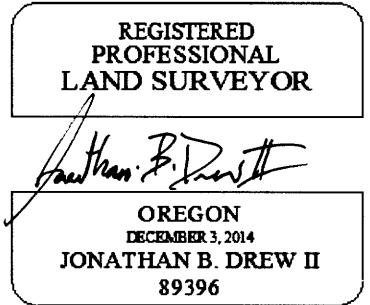

EXPIRES: 12/31/2015

RECORD MEASUREMENTS:


- (S35°W-9.2 FT)1857
(N70°E-23.1 FT)1857
(S51°W-29.0 FT)1922 & 1968
(N17°W-32.2 FT)1922 & 1968
(N30°W-7.2')1968
(S26°W-18.0 FT)1968
(S0°12'W-87.8 FT)1922 & 1968

METHOD OF MEASUREMENT:

NO NEW MEASUREMENTS TAKEN.

FILED AS CONDITION REPORT.

CAP DIAGRAM:

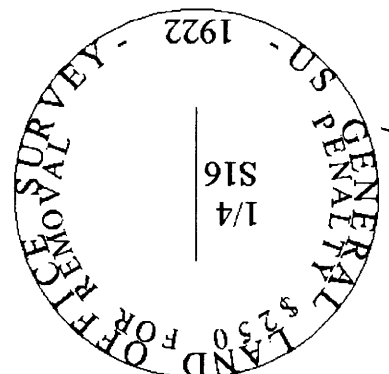

C.S. File No 65/90-17

THIS DOCUMENT FILED IN CS OFFICE: YES
OTHER DOCUMENT FILED WITH CS: NONE