

FS INDEX ID: E-5

CORNER INVESTIGATION REPORT

CORNER: SECTION GCDB ID: 200600 DATE: 5/25/2015
TOWNSHIP: 32S STATE: OREGON
RANGE: R1W COUNTY: DOUGLAS
SECTION: 5, 6, 7 & 8 FOREST: UMPQUA
MERIDIAN: W.M. DISTRICT: TILLER

HISTORY OF VISITATIONS:

1883-R.S. MOORE, GLO SURVEY
1968-J.M. POWELL ET. AL, CS 54/71
1970-B.A. SHANER, RM 2-21
1980-B.A. SHANER, RM 3-37 & M79-67
1989-G.V. NYGREN, USFS CORNER CARD


NFSL PROPERTY BOUNDARY CORNER?: [x] YES [ ] NO
LINE(S) POSTED: NORTH-1980 SOUTH-1980 EAST-1980 WEST-1970
MAINTAINED: NORTH-NONE SOUTH-1989 EAST-1989 WEST-2015
GUARD POST(S): NORTH-6.0 FT SOUTH-34.0FT EAST-3.2FT WEST-4.4FT

CORNER HISTORY:

(1883)-ESTABLISHED SECTION CORNER, SET STONE & 4 BT'S.
(1968)-FINDS STONE & 3 BT'S, SETS BRASS CAP/IRON PIPE & 3 BT'S.
(1970)-FINDS BRASS CAP/IRON PIPE & 4 BT'S.
(1980)-FINDS BRASS CAP/IRON PIPE & 6 BT'S, SETS 1 NEW BT.
(1989)-FINDS BRASS CAP/IRON PIPE & 5 BT'S. CORNER IN 1987 FIRE, NO LIVE BT'S.

MONUMENT FOUND/SET:

FOUND A 2-1/2" DCSO BRASS CAP ON 1-1/4" GALVANIZED IRON PIPE, PROJECTING 11 INCHES ABOVE A MOUND OF STONE.

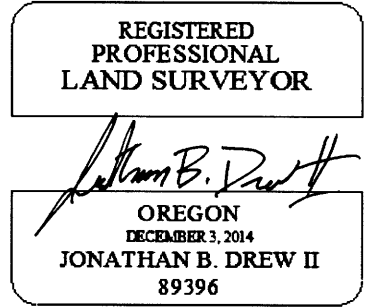

EXPIRES: 12/31/2015

RECORD CORNER ACCESSORIES:

A 20" FIR SNAG BEARS, N33°15'E - 4.0 FT, WITH A PARTIALLY HEALED SINGLE BLAZE
NO TRACE FOUND OF A (12" FIR)1883
NO TRACE FOUND OF A (6" MATHERONE)1883
A 22" FIR STUMP BEARS, N40°15'W - 5.0 FT, WITH NO MARKS VISIBLE.
A 22" FIR STUMP BEARS, S27°W - 31.3 FT, WITH A HEALED SINGLE BLAZE.
A 10" FIR STUB BEARS, S2°45'E - 17.4 FT, WITH SCRIBE VISIBLE ON EXPOSED FACE.
AN INDETERMINATE SIZE FIR STUMP BEARS, N63°W - 20.6 FT, WITH AX WORK.
ROTTEN REMAINS OF AN INDETERMINATE SIZE FIR BEARS, N69°W - 28.5 FT.

RECORD MEASUREMENTS:

(N43°E-4.0')1883
(S75°E-4.6')1883
(S12°W-13.2')1883
(N45°W-4.0')1883
(S25°W-31.2')1968
(S3°E-17.5')1968
(N65°W-20.6')1968
(N66°W-28.1')1980

NEW CORNER ACCESSORIES:

A 11" PINE BEARS, N22°30'E - 58.1 FT, MARKED "T32SR1WS5""BT" ON DOUBLE BLAZE.
A 9" PINE BEARS, S67°E - 40.4 FT, MARKED "T32SR1WS8""BT" ON A DOUBLE BLAZE.
A 7" PINE S9°45'W - 20.6 FT, MARKED "X""BT" ON A DOUBLE BLAZE.
A 12" PINE BEARS, N63°15'W - 38.4 FT, MARKED "T32SR1WS6""BT" ON DOUBLE BLAZE


METHOD OF MEASUREMENT:

LEICA TCR1201 TOTAL STATION.
TRIMBLE R6 RTK GPS SYSTEM
BEARING BASIS: MEAN GEODETIC
DETERMINED BY OBSERVATIONS OF
CORNER AND SPIKE SET N46°56'17"W
114.62 FT ON EDGE OF ROAD.

CORNER MAINTENANCE/OTHER INFO:

CLEAR BRUSH FROM AROUND MONUMENT AND TO BT'S. TIE FLAGGING TO
MONUMENT AND GUARD POSTS, PAINT BT FACES & A 6" BAND AT HEAD HEIGHT,
ADD NEW NAILS TO EXISTING BT TAGS & ADD NEW TAGS WHERE NEEDED.

CAP DIAGRAM:

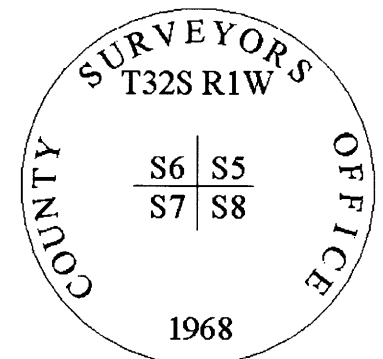

NEW BT'S INCLUDE A 3/4" BRASS WASHER STAMPED "ORPLS #89396" BETWEEN B&T

GEODETIC COORDINATES:

DOCUMENTS ON FILE AT:

LATTITUDE: N 42° 48' 37.48773" 3106 PIERCE PARKWAY, STE. D
LONGITUDUE: W 122° 51' 14.71715" SPRINGFIELD, OREGON 97477
ELIPSOID HEIGHT: 2132.8 FT
DATUM: PER OPUS: NAD\_83(2011)(EPOCH:2010.0000)

SOURCE: RTK&STATIC GPS OBSERVATIONS FROM OPUS CORRECTED BASE.

DATE OF INVESTIGATION: 5/13/2015

REPORT BY: JONATHAN B. DREW II, PLS 89396

ASSISTED BY: LANCE GOUCHER, SURVEY TECH.

THIS DOCUMENT FILED IN CS OFFICE: YES
OTHER DOCUMENT FILED WITH CS: NONE

C.S. File No 65/90-20