

FS INDEX ID: J-5

CORNER INVESTIGATION REPORT

CORNER: SECTION GCDB ID: 200500 DATE: 4/24/2015
TOWNSHIP: 31 S STATE: OREGON
RANGE: 1 W COUNTY: DOUGLAS
SECTION: 7, 8, 17 & 18 FOREST: UMPQUA
MERIDIAN: W.M. DISTRICT: TILLER
NFSL PROPERTY BOUNDARY CORNER?: [X] YES [] NO
LINE(S) POSTED: NORTH-1977 EAST-1972
MAINTAINED: NORTH-2015 EAST-2015
GUARD POST(S): NORTH-4.0 FT EAST-2.6 FT
CORNER HISTORY:

(1857)-ESTABLISHED SECTION CORNER, SETS WOOD POST & 4 BT'S.
(1966)-FINDS 4 BT'S, 3 DOWNED, SETS BRASS CAP/IRON POST & 4 BT'S.
(1972)-FINDS BRASS CAP/IRON PIPE & 5 BT'S. (1977)-FINDS BC/IP & 7 BT'S, 2 DOWN.
(2001)-FINDS BRASS CAP/IRON PIPE & 5 BT'S.
(2003)-FINDS BRASS CAP/IRON POST & 5 BT'S, MARKS 1 NEW BT.

MONUMENT FOUND/SET:

FOUND A 2-1/2" BRASS CAP ON 1-1/4" GALVANIZED IRON PIPE, PROJECTING 17 INCHES ABOVE A MOUND OF STONE.

RECORD CORNER ACCESSORIES:

NO TRACE FOUND OF A (12" OAK)1857, (24" B.OAK STUMP)2003
NO TRACE FOUND OF A (12" OAK)1857, (18" OAK WINDFALL)1977
NO TRACE FOUND OF A (15" OAK)1857, (15" DOWN OAK)1966
NO TRACE FOUND OF A (15" OAK)1857, (24" OAK WINDFALL)1977
A 21" FIR WITH A HEALED DOUBLE BLAZE.
A 23" MADRONE WITH A FAINT HEALED DOUBLE BLAZE.
A 16" FIR HIGH STUMP WITH A HEALED DOUBLE BLAZE.
AN INDETERMINATE SIZED ROTTEN FIR STUMP WITH NO MARKS VISIBLE.
A 15" CEDAR WITH SCRIBE VISIBLE ON A PARTIALLY HEALED SINGLE BLAZE.

NEW CORNER ACCESSORIES:

MISSING LIVE TREE IN SW QUAD, RECENT CLEARING, NO SUITABLE TREES WITHIN 3 CHAIN LIMIT. EXISTING HIGH STUMP IS IN GOOD CONDITION.

CORNER MAINTENANCE/OTHER INFO:

CLEAR BRUSH FROM AROUND MONUMENT AND TO BT'S. TIE FLAGGING TO MONUMENT AND GUARD POSTS, PAINT BT FACES & A 6" BAND AT HEAD HEIGHT, ADD NEW NAILS TO EXISTING BT TAGS & ADD NEW TAGS WHERE NEEDED.

GEODETIC COORDINATES:

LATTITUDE: N42°53'14.706
LONGITIDUE: W122°51'48.647"
ELIPSOID HEIGHT:
DATUM: WGS 84

SOURCE: USGS QUAD MAP, FOR NAVIGATION TO CORNER.

DATE OF INVESTIGATION: 4/22/2015


REPORT BY: JONATHAN B. DREW II, PLS 89396

ASSISTED BY: LANCE GOUCHER, SURVEY TECH.

DOCUMENTS ON FILE AT:


3106 PIERCE PARKWAY, STE. D
SPRINGFIELD, OREGON 97477

HISTORY OF VISITATIONS:
1857-DENNIS HATHORN, GLO SURVEY
1966-JOHN POWELL, ET. AL, CS 54/28
1972-J.A. HOFFBUHR, M45-75 & M45-80
1977-WILLIAM RUPPERT, M65-60&M65-50
1984-L.E. HERZSTEIN, CS 62/15
2001-L.L. FANNING, CS 65/36-10
2003-L.E. HERZSTEIN, BLM RESURVEY

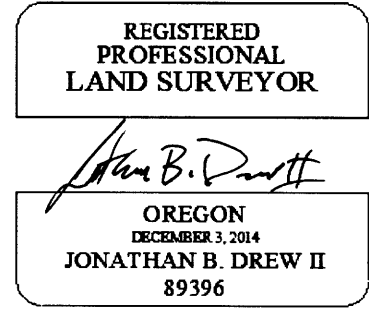

EXPIRES: 12/31/2015
RECORD MEASUREMENTS:
(S55°W-65.3 FT)1857, (64.3 FT)2003
(N12°W-73.9')1857, (N10°33'W-74.0')1977
(S45°E-99.0 FT)1857&1966
(N38°E-58.1')1857, (N42°07'E-58.0')1977
(N47°E-26.3 FT)1966, (26.0 FT)2003
(N62°W-17.0')1966, (N59°30'W-16.7')2003
(S37°W-28.1')1966, (S38°W-27.2')2003
(S50°E-52.0 FT)1966, (51.6 FT)2003
(S23°45'E - 182.7 FT)2003

METHOD OF MEASUREMENT:
NO NEW MEASURMENTS TAKEN
FILED AS CONDITION REPORT.

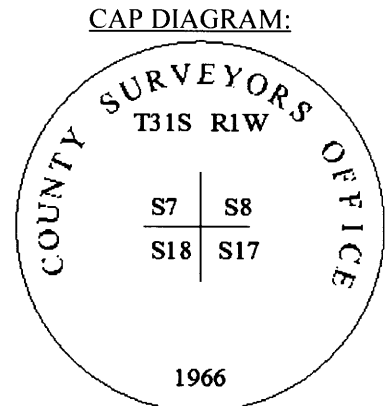

THIS DOCUMENT FILED IN CS OFFICE: YES
OTHER DOCUMENT FILED WITH CS: NONE

C.S. File No 65/90-23