

FS INDEX ID: J-9

CORNER INVESTIGATION REPORT

CORNER: SECTION **GCDB ID:** 300500 **DATE:** 6/1/2015
TOWNSHIP: 32S **STATE:** OREGON
RANGE: 1W **COUNTY:** DOUGLAS
SECTION: 8, 9, 16 & 17 **FOREST:** UMPQUA
MERIDIAN: W.M. **DISTRICT:** TILLER
NFSL PROPERTY BOUNDARY CORNER?: YES NO
LINE(S) POSTED: NORTH-1979 SOUTH-1979^ EAST-1979 WEST-1979
MAINTAINED: NORTH-1986 SOUTH-1986 EAST-1986 WEST-2015
GUARD POST(S): NORTH-1.8 FT SOUTH-5.9 FT EAST-NONE WEST-NONE
CORNER HISTORY:

HISTORY OF VISITATIONS:
1883-R.S. MOORE, GLO SURVEY
1968-J.M. POWELL ET AL., CS 54/71
1968^ - HEISLEIN, USFS CORNER CARD
1979^ - G..S BAUGHMAN, USFS CNR. CARD
1979-K.C. WEAVER, CS 58/176
1986-L.R. MOFFIT, USFS CORNER CARD

(1883)-ESTABLISHED SECTION CORNER, SETS STONE & 4 BT'S.
(1968)-FINDS 2 BT'S, SETS BRASS CAP/I.P.I.PE & 4 BT'S. (1968^)-FINDS BC/IP & 4 BT'S
(1979)-FINDS BC/IP & 5 BT'S, SETS 1 NEW BT. (1979^)-FINDS BC/IP & 6 BT'S.
1986-FINDS BRASS CAP/IRON PIPE & 4 BT'S.

MONUMENT FOUND/SET:
FOUND A 2-1/2" DCSO BRASS CAP ON 1-1/4" GALVANIZED IRON PIPE, PROJECTING 10 INCHES ABOVE A MOUND OF STONE.


RECORD CORNER ACCESSORIES:
NO TRACE FOUND OF A (3" S.PINE)1883
A ROOT HOLE & ROTTEN REMAINS OF PINE WITH NO MARKS VISIBLE.
NO TRACE FOUND OF A (8" MATHERONE)1883
A ROOT HOLE & ROTTEN REMAINS OF PINE WITH NO MARKS VISIBLE.
A 18" FIR HIGH STUMP WITH SCRIBE VISIBLE ON A PARTIALLY HEALED UPPER BLAZE & A HEALED LOWER BLAZE.
A 16" FIR WITH A HEALED DOUBLE BLAZE.
A 7" OAK WITH SCRIBE VISIBLE ON A PARTIALLY HEALED DOUBLE BLAZE.
A 11" OAK WITH SCRIBE VISIBLE ON A PARTIALLY HEALED DOUBLE BLAZE.
A 21" FIR WITH A HEALED DOUBLE BLAZE.

NEW CORNER ACCESSORIES:
NO NEW ACCESSORIES NEEDED.

CORNER MAINTENANCE/OTHER INFO:
CLEAR BRUSH FROM AROUND MONUMENT AND TO BT'S. TIE FLAGGING TO MONUMENT AND GUARD POSTS, PAINT BT FACES & A 6" BAND AT HEAD HEIGHT, ADD NEW NAILS TO EXISTING BT TAGS & ADD NEW TAGS WHERE NEEDED.

GEODETIC COORDINATES:
LATTITUDE: N 42° 47' 42.215"
LONGITUDE: W 122° 50' 01.508"
ELIPSOID HEIGHT: 3120 FT
DATUM: WGS 84
SOURCE: CELL PHONE GPS, FOR NAVIGATION TO CORNER.
DATE OF INVESTIGATION: 5/27/2015
REPORT BY: JONATHAN B. DREW II, PLS 89396
ASSISTED BY:


DOCUMENTS ON FILE AT:
3106 PIERCE PARKWAY, STE. D
SPRINGFIELD, OREGON 97477

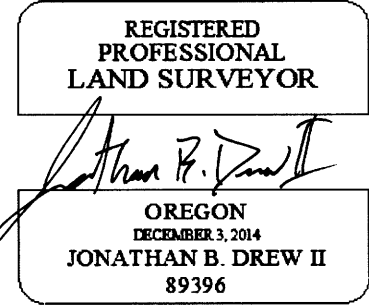

EXPIRES: 12/31/2015
RECORD MEASUREMENTS:
(N68°E-18.5 FT)1883
(S32°E-9.9 FT)1883 & 1968
(S40°W-21.8 FT)1883
(N58°W-27.7')1883,(N57°20'W-28.2')1979
(S50°E-20.3')1968, (S47°51'E-20.1')1979
(EAST-11.1 FT)1968, (11.0 FT)1979
(N5°W-10.9')1968, (N4°52'W-10.6')1979
(S80°W-17.8')1968, (S80°59'W-17.3')1979
(N75°30'E-98.0 FT)1979

METHOD OF MEASUREMENT:
NO NEW MEASUREMENTS TAKEN.

FILED AS CONDITION REPORT.

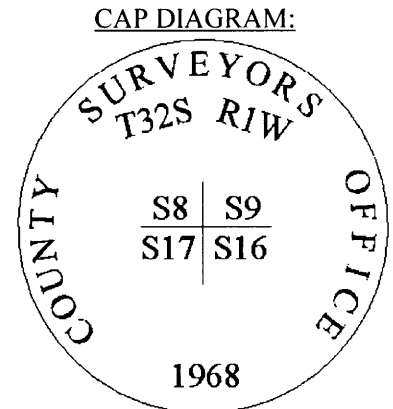

THIS DOCUMENT FILED IN CS OFFICE: YES
OTHER DOCUMENT FILED WITH CS: NONE

C.S. File No 65/90-25