

FS INDEX ID: D-24

CORNER INVESTIGATION REPORT

CORNER: SE 1/16
TOWNSHIP: 32S
RANGE: 2W
SECTION: 1
MERIDIAN: W.M.

GCDB ID: 660620
STATE: OREGON
COUNTY: DOUGLAS
FOREST: UMPQUA
DISTRICT: TILLER

DATE: 6/5/2015

HISTORY OF VISITATIONS:
1970-B.A. SHANER, RM 2-21
1980-L. HERZSTEIN, USFS CNR CARD

NFSL PROPERTY BOUNDARY CORNER?: YES NO



LINE(S) POSTED: SOUTH-1970 EAST-1970

MAINTAINED: SOUTH-2015 EAST-2015

GUARD POST(S): SOUTH-4.3 FT EAST-4.9 FT

CORNER HISTORY:

(1970)-ESTABLISHED SE1/16 CORNER, SETS BRASS CAP/IRON PIPE & 2 BT'S
(1980)-REPORTS CORNER OK, PLACED SIGNS ON 2 BT'S.

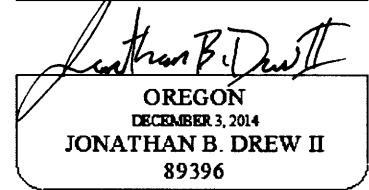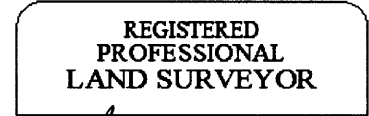

EXPIRES: 12/31/2015

MONUMENT FOUND/SET:

FOUND A 3" BRASS CAP ON 2-1/2" GALVANIZED IRON PIPE, PROJECTING 5 INCHES ABOVE THE GROUND.

RECORD MEASUREMENTS:

RECORD CORNER ACCESSORIES:

A 25" CEDAR HIGH STUMP BEARS, N23°15'W - 93.4 FT, WITH AX WORK & NO VISIBLE FACE.

(N21°W-94.1')1970

A 26" FIR HIGH STUMP BEARS, S58°W - 29.9 FT, WITH A ROTTED OUT SINGLE BLAZE.

(S55°W-31.0')1970

NEW CORNER ACCESSORIES:

A 6" CEDAR BEARS, S5°30'W - 68.4 FT, MARKED "X" "BT" ON A DOUBLE BLAZE.
A 17" FIR BEARS, S85°E - 14.3 FT, MARKED "SE1/16S1" "BT" ON A DOUBLE BLAZE.


METHOD OF MEASUREMENT:

LEICA TCRA 1103+, HOLD S0°47'E ON STEEL LINE POST FOUND 128.0 FT SOUTH OF CORNER.
BEARINGS TO CENTER, DISTANCES TO NAIL SET SIDE CENTER.

CORNER MAINTENANCE/OTHER INFO:

CLEAR BRUSH FROM AROUND MONUMENT AND TO BT'S. TIE FLAGGING TO MONUMENT AND GUARD POSTS, PAINT BT FACES & A 6" BAND AT HEAD HEIGHT, ADD NEW NAILS TO EXISTING BT TAGS & ADD NEW TAGS WHERE NEEDED.

CAP DIAGRAM:

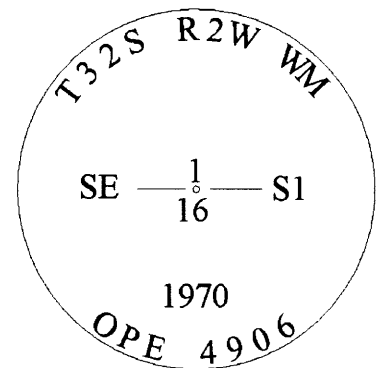

GEODETTIC COORDINATES:

LATTITUDE: N 42° 48' 52.448"
LONGITUDUE: W 122° 52' 41.408"
ELIPSOID HEIGHT: 3085 FT
DATUM: WGS 84

DOCUMENTS ON FILE AT:

3106 PIERCE PARKWAY, STE. D
SPRINGFIELD, OREGON 97477

SOURCE: CELL PHONE GPS, FOR NAVIGATION TO CORNER

DATE OF INVESTIGATION: 6/4/2015

REPORT BY: JONATHAN B. DREW II, PLS 89396

ASSISTED BY:

THIS DOCUMENT FILED IN CS OFFICE: YES
OTHER DOCUMENT FILED WITH CS: NONE

C.S. File No 65/90-30