

FS INDEX ID: E-23

CORNER INVESTIGATION REPORT

CORNER: 1/4
TOWNSHIP: 32S
RANGE: 2W
SECTION: 1 & 12
MERIDIAN: W.M.
NFSL PROPERTY BOUNDARY CORNER?: YES NO

GCDB ID: 640600
STATE: OREGON
COUNTY: DOUGLAS
FOREST: UMPQUA
DISTRICT: TILLER

DATE: 6/1/2015

HISTORY OF VISITATIONS:
 1902-C.L. CAMPBELL, GLO SURVEY
 1963-J.W. BYRON, CS 54/15
 1970-B.A. SHANER, RM 2-21
 1980-L. HERZSTEIN, USFS CNR CARD

LINE(S) POSTED: NORTH-1970 EAST-1970
MAINTAINED: NORTH-2015 EAST-2015
GUARD POST(S): NORTH-4.8FT EAST-5.5FT

CORNER HISTORY:


- (1902)-ESTABLISHED 1/4 CORNER, SETS STONE & 2 BT'S.
- (1963)-FINDS STONE & 1 BT, SETS BRASS CAP/IRON PIPE & 1 NEW BT.
- (1970)-FINDS BRASS CAP/IRON PIPE & 2 BT'S, SETS 1 NEW BT.
- (1980)-FINDS CORNER OK, PLACED SIGNS ON 3 BT'S

MONUMENT FOUND/SET:

FOUND A 2-1/2" DCSO BRASS CAP ON 1-1/4" GALVANIZED IRON PIPE, PROJECTING 10" ABOVE A MOUND OF STONE.

RECORD CORNER ACCESSORIES:

- NO TRACE FOUND OF A (12" FIR)1902
- A ROTHOLE BEARS, N23°45'W - 14.7 FT, WITH A ROTTEN FIR WINDFALL LIES WEST.
- AN INDETERMINATE SIZE ROTTEN FIR STUB BEARS, S68°E - 51.9 FT, WITH NO MARKS
- A 25" FIR BEARS, N19°W - 43.8 FT, WITH A HEALED SINGLE BLAZE.

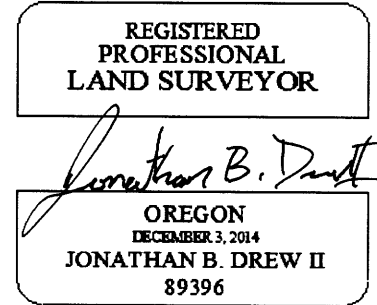

EXPIRES: 12/31/2015
RECORD MEASUREMENTS:

- (S28°E-29.7')1902
- (N23°W-13.9')1902
- (S68°E-52.5')1968
- (N18°30'W-44.2')1970

NEW CORNER ACCESSORIES:

- A 16" FIR BEARS, S50°15'E - 4.3 FT, MARKED "1/4S12""BT" ON A DOUBLE BLAZE.
- A 19" FIR BEARS, S40°30'W - 30.0 FT, MARKED "1/4S12""BT" ON A DOUBLE BLAZE.
- A 8" FIR BEARS, N75°W - 15.5 FT, MARKED "X""BT" ON A DOUBLE BLAZE.

METHOD OF MEASUREMENT:

LEICA TCRA1103+ TOTAL STATION HOLD BEARING S89°36'E ON STEEL LINE POST FOUND EAST 151.4 FEET PER RM2-21. DISTANCES TO NAIL SET SIDE CENTER, BEARINGS TO CENTER.

CORNER MAINTENANCE/OTHER INFO:

CLEAR BRUSH FROM AROUND MONUMENT AND TO BT'S. TIE FLAGGING TO MONUMENT AND GUARD POSTS, PAINT BT FACES & A 6" BAND AT HEAD HEIGHT, ADD NEW NAILS TO EXISTING BT TAGS & ADD NEW TAGS WHERE NEEDED.

NEW BT'S INCLUDE A 3/4" BRASS WASHER STAMPED "ORPLS #89396" BETWEEN B&T

GEODETIC COORDINATES:

LATTITUDE: N 42° 48' 39.640"
LONGITUDUE: W 122° 52' 58.941"
ELIPSOID HEIGHT: 3200 FT
DATUM: WGS 84

DOCUMENTS ON FILE AT:

3106 PIERCE PARKWAY, STE. D
 SPRINGFIELD, OREGON 97477


SOURCE: CELL PHONE GPS, FOR NAVIGATION TO CORNER

DATE OF INVESTIGATION: 5/19/2015

REPORT BY: JONATHAN B. DREW II, PLS 89396

ASSISTED BY: LANCE GOUCHER, SURVEY TECH.

CAP DIAGRAM:

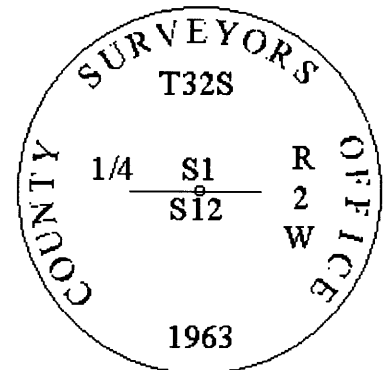

THIS DOCUMENT FILED IN CS OFFICE: YES
OTHER DOCUMENT FILED WITH CS: NONE

C.S. File No 65/90-31