

FS INDEX ID: A-16

CORNER INVESTIGATION REPORT


CORNER: E 1/16 **GCDB ID:** 460700 **DATE:** 7/31/2015 **HISTORY OF VISITATIONS:**
TOWNSHIP: 30S & 31S **STATE:** OREGON 1978-G.S. BAUGHMAN, M65-69
RANGE: 2W **COUNTY:** DOUGLAS
SECTION: 34 & 3 **FOREST:** UMPQUA
MERIDIAN: W.M. **DISTRICT:** TILLER
NFSL PROPERTY BOUNDARY CORNER?: YES NO

LINE(S) POSTED: SOUTH-1978 EAST-1978
MAINTAINED: SOUTH-2015 EAST-2015
GUARD POST(S): SOUTH-3.9 FT EAST-2.8 FT

CORNER HISTORY:

(1978)-ESTABLISHED EAST 1/16 CORNER, SETS BRASS CAP/IRON PIPE & 2 BT'S.

REGISTERED
PROFESSIONAL
LAND SURVEYOR

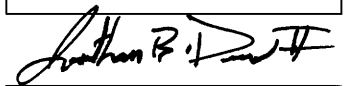

OREGON
DECEMBER 3, 2014
JONATHAN B. DREW II
89396

EXPIRES: 12/31/2015

RECORD MEASUREMENTS:

(N67°E - 125.4 FT)1978
(S7°E - 59.9 FT)1978

MONUMENT FOUND/SET:

FOUND A 3" BRASS CAP ON 2-1/2" GALVANIZED IRON PIPE, PROJECTING 1 INCH ABOVE A MOUND OF STONE.

RECORD CORNER ACCESSORIES:

A 18" FIR WITH A HEALED DOUBLE BLAZE.
A 15" FIR WITH A HEALED DOUBLE BLAZE.

FILED

Date: 8-25-2015 By: X
This survey consists of:
Map: _____
Narrative: _____
Corner Rpt. CS 65/90-35

DOUGLAS COUNTY
SURVEYOR

NEW CORNER ACCESSORIES:

NO NEW ACCESSORIES ADDED.

METHOD OF MEASUREMENT:


NO NEW MEASUREMENTS TAKEN.

FILED AS CONDITION REPORT.

CORNER MAINTENANCE/OTHER INFO:

CLEAR BRUSH FROM AROUND MONUMENT AND TO BT'S. TIE FLAGGING TO MONUMENT AND GUARD POSTS, PAINT BT FACES & A 6" BAND AT HEAD HEIGHT. ADD NEW NAILS TO EXISTING BT TAGS & ADD NEW TAGS WHERE NEEDED.

CAP DIAGRAM:

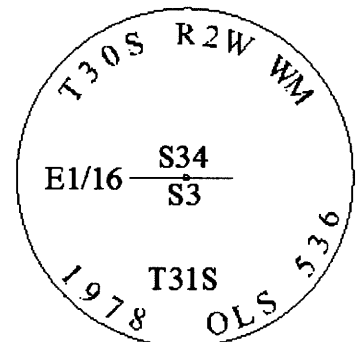

GEODETIC COORDINATES:

LATITUDE: N 42° 54' 59.568"
LONGITUDE: W 122° 55' 39.709"
ELLIPSOID HEIGHT: 1550 FT
DATUM: WGS 84

DOCUMENTS ON FILE AT:

3106 PIERCE PARKWAY, STE. D
SPRINGFIELD, OREGON 97477

SOURCE: CELL PHONE GPS, FOR NAVIGATION TO CORNER.

DATE OF INVESTIGATION: 7/15/2015

REPORT BY: JONATHAN B. DREW II, PLS#89396, CFedS#1664

ASSISTED BY: ANDREW HILLMAN, SURVEY TECH.

THIS DOCUMENT FILED IN CS OFFICE: YES

OTHER DOCUMENT FILED WITH CS: NONE

C.S. File No 65/90-35