

FS INDEX ID: B-17

CORNER INVESTIGATION REPORT

CORNER: N 1/16
TOWNSHIP: 31S
RANGE: 2W
SECTION: 2 & 3
MERIDIAN: W.M.

GCDB ID: 500660
STATE: OREGON
COUNTY: DOUGLAS
FOREST: UMPQUA
DISTRICT: TILLER

DATE: 7/31/2015

HISTORY OF VISITATIONS:

1978-G.S. BAUGHMAN, M65-68 & M65-69
2009-USFS SURVEY CREW, NO RECORD

NFSL PROPERTY BOUNDARY CORNER?: [X] YES [] NO


LINE(S) POSTED: SOUTH-1978 WEST-1978

MAINTAINED: SOUTH-2009 WEST-2015


GUARD POST(S): SOUTH-2.7 FT WEST-3.1 FT

CORNER HISTORY:

(1978)-ESTABLISHED NORTH 1/16 CORNER, SETS BRASS CAP/IRON PIPE & 2 BT'S.

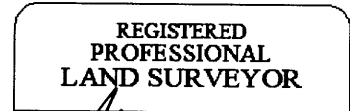

Handwritten signature of Jonathan B. Drew II

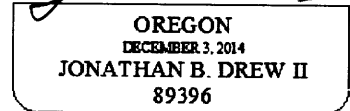

EXPIRES: 12/31/2015

RECORD MEASUREMENTS:

(S70°W - 15.9 FT)1978

(N82°E - 50.1 FT)1978

MONUMENT FOUND/SET:

FOUND A 3" BRASS CAP ON 2-1/2" GALVANIZED IRON PIPE, PROJECTING 4 INCHES ABOVE A MOUND OF STONE.

RECORD CORNER ACCESSORIES:

A ROOT HOLE BEARS, S61°15'W - 16.1 FT, WITH A 9" FIR WINDFALL LOG LAYS NORTHEAST ON FACE.

A 13" FIR BEARS, N82°E - 49.5 FT, WITH A HEALED DOUBLE BLAZE.

NEW CORNER ACCESSORIES:

A 14" FIR BEARS, N57°W - 32.7 FT, MARKED "N1/16S3BT" ON A SINGLE BLAZE.


METHOD OF MEASUREMENT:

LEICA TCRA 1103+ TOTAL STATION HOLD BEARING N89°08'46"W ON STEEL POST FOUND 101.0 FT WEST OF CORNER. DISTANCES TO NAIL SET SIDE CENTER, BEARINGS TO CENTER.

CORNER MAINTENANCE/OTHER INFO:

CLEAR BRUSH FROM AROUND MONUMENT AND TO BT'S. TIE FLAGGING TO MONUMENT AND GUARD POSTS. PAINT BT FACES & A 6" BAND AT HEAD HEIGHT, ADD NEW NAILS TO EXISTING BT TAGS & ADD NEW TAGS WHERE NEEDED.

CAP DIAGRAM:

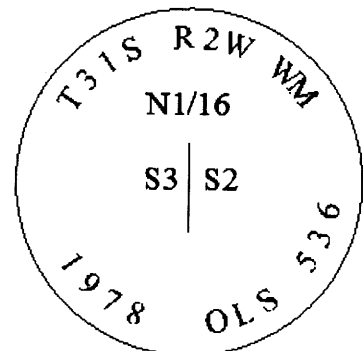

NEW BT INCLUDES A 3/4" BRASS WASHER. "ORPLS#89396" NAILED BETWEEN B & T.

GEODETIC COORDINATES:

LATITUDE: N 42° 54' 46.270"
LONGITUDE: W 122° 55' 20.813"
ELLIPSOID HEIGHT: 1970 FT

DOCUMENTS ON FILE AT:

3106 PIERCE PARKWAY, STE. D
SPRINGFIELD, OREGON 97477

DATUM: WGS 84

SOURCE: CELL PHONE GPS, FOR NAVIGATION TO CORNER.

DATE OF INVESTIGATION: 7/15/2015

REPORT BY: JONATHAN B. DREW II, PLS#89396, CFedS#1664

ASSISTED BY: ANDREW HILLMAN, SURVEY TECH.

THIS DOCUMENT FILED IN CS OFFICE: YES

OTHER DOCUMENT FILED WITH CS: NONE

C.S. File No 65/96-37