

FS INDEX ID: C-22

# CORNER INVESTIGATION REPORT

CORNER: CW 1/16                      GCDB ID: 620640  
TOWNSHIP: 31S                        STATE: OREGON  
RANGE: 2W                              COUNTY: DOUGLAS  
SECTION: 1                              FOREST: UMPQUA  
MERIDIAN: W.M.                      DISTRICT: TILLER  
NFSL PROPERTY BOUNDARY CORNER?:  YES  NO  
LINE(S) POSTED: SOUTH-1978    WEST-1978  
MAINTAINED: SOUTH-2015        WEST-2015  
GUARD POST(S): SOUTH-2.7 FT    WEST-2.3 FT  
CORNER HISTORY:

DATE: 6/17/2015

HISTORY OF VISITATIONS:

1978-G.S. BAUGHMAN, M65-79  
 1992-G.S. BAUGHMAN, M115-43

(1978)-ESTABLISHED CW 1/16 CORNER, SETS BRASS CAP/IRON PIPE & 2 BT'S.  
 (1992)-FINDS BRASS CAP/IRON PIPE & 2 BT'S

MONUMENT FOUND/SET:

FOUND A 3" BRASS CAP ON 2-1/2" GALVANIZED IRON PIPE, PROJECTING 7 INCHES ABOVE A MOUND OF STONE.

RECORD CORNER ACCESSORIES:

A 16" FIR WITH A HEALED DOUBLE BLAZE.  
 A 16" FIR WITH A HEALED DOUBLE BLAZE.

REGISTERED  
 PROFESSIONAL  
 LAND SURVEYOR



OREGON  
 DECEMBER 3, 2014  
 JONATHAN B. DREW II  
 89396

EXPIRES: 12/31/2015

RECORD MEASUREMENTS:

(S13°W-16.3 FT)1978  
 (S79°E-12.0 FT)1978

**FILED**

Date: 8-25-2015 By: x

This survey consists of:

Map: \_\_\_\_\_

Narrative: \_\_\_\_\_

Corner Rpt: CS 65/90-42

DOUGLAS COUNTY  
 SURVEYOR

NEW CORNER ACCESSORIES:

NO NEW ACCESSORIES ADDED.

METHOD OF MEASUREMENT:

NO NEW MEASUREMENTS TAKEN.

CORNER MAINTENANCE/OTHER INFO:

CLEAR BRUSH FROM AROUND MONUMENT AND TO BT'S. TIE FLAGGING TO MONUMENT AND GUARD POSTS. PAINT BT FACES & A 6" BAND AT HEAD HEIGHT. ADD NEW NAILS TO EXISTING BT TAGS & ADD NEW TAGS WHERE NEEDED.

FILED AS CONDITION REPORT.

GEODETTIC COORDINATES:

LATITUDE: N 42° 54' 32.610"  
LONGITUDE: W 122° 53' 52.742"  
ELLIPSOID HEIGHT: 2290 FT  
DATUM: WGS 84

DOCUMENTS ON FILE AT:

3106 PIERCE PARKWAY, STE. D  
 SPRINGFIELD, OREGON 97477


SOURCE: CELL PHONE GPS. FOR NAVIGATION TO CORNER.

DATE OF INVESTIGATION: 6/10/2015

REPORT BY: JONATHAN B. DREW II, PLS#89396, CFedS#1664

ASSISTED BY: ANDREW HILLMAN, SURVEY TECH.

CAP DIAGRAM:

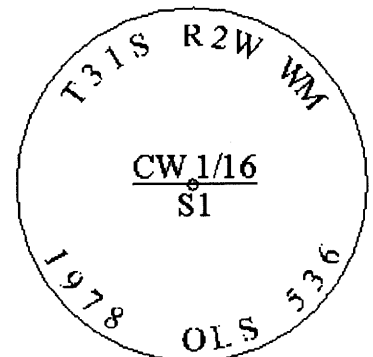

THIS DOCUMENT FILED IN CS OFFICE: YES  
OTHER DOCUMENT FILED WITH CS: NONE

**C.S. File No** 65/90-42