

FS INDEX ID: E-17

CORNER INVESTIGATION REPORT


CORNER: SECTION GCDB ID: 500600 DATE: 6/17/2015
TOWNSHIP: 31S STATE: OREGON
RANGE: 2W COUNTY: DOUGLAS
SECTION: 2, 3, 10 & 11 FOREST: UMPQUA
MERIDIAN: W.M. DISTRICT: TILLER
NFSL PROPERTY BOUNDARY CORNER?: [X] YES [] NO
LINE(S) POSTED: NORTH-1978 SOUTH-NONE EAST-1978 WEST-1978
MAINTAINED: NORTH-2009 SOUTH-NONE EAST-2015 WEST-NONE
GUARD POST(S): NORTH-2.2 FT SOUTH-6.0 FT EAST-5.3 FT WEST-3.8 FT
CORNER HISTORY:

HISTORY OF VISITATIONS:
1857-DENNIS HATHORN, GLO SURVEY
1928-H.L. EPPSTEIN ET. AL, V.3 Pg.287
1966-JOHN M. POWELL ET. AL, CS 54/28
1978-G.S. BAUGHMAN, M65-68 & M65-69
2009-USFS SURVEY CREW. NO RECORD

(1857)-ESTABLISHED SECTION CORNER, SETS POST & 4 BT'S.
(1928)-FINDS 3 BT'S, SETS POST & 4 BT'S.
(1966)-FINDS 4 BT'S, SETS BRASS CAP/IRON PIPE & 3 BT'S.
(1978)-FINDS BRASS CAP/IRON PIPE & 7 BT'S.

MONUMENT FOUND/SET:

FOUND A 2-1/2" BRASS CAP ON 1-1/4" GALVANIZED IRON PIPE, PROJECTING 8 INCHES ABOVE A MOUND OF STONE.

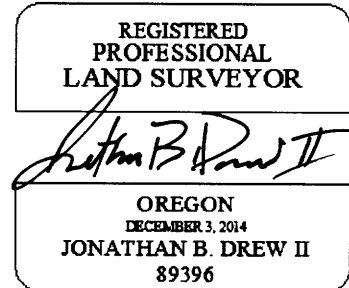

EXPIRES: 12/31/2015
RECORD MEASUREMENTS:

RECORD CORNER ACCESSORIES:

NO TRACE FOUND OF A (9" PINE)1857, LARGE PINE IN VICINITY PREVIOUSLY OPENED
NO TRACE FOUND OF A (40" PINE)1857
ROTTEN REMAINS OF AN INDETERMINATE SIZE OAK WITH NO MARKS VISIBLE.
NO TRACE FOUND OF A (30" OAK)1857
A 34" FIR STUMP WITH AX WORK VISIBLE, NO VISIBLE FACE.
AN INDETERMINATE SIZE FIR WINDFALL LOG WITH NO MARKS OR ROOT HOLE.
A 9" OAK WITH A HEALED DOUBLE BLAZE.
A 27" FIR WITH A HEALED SINGLE BLAZE.
A 16" FIR WITH A HEALED DOUBLE BLAZE.
A 26" MADRONE WITH A FAINT HEALED SINGLE BLAZE.
A 26" FIR WITH A HEALED DOUBLE BLAZE.

(N52°E - 67.3 FT)1857
(S60°E - 55.4 FT)1857
(N73°W - 40.3 FT)1857
(S62°W - 64.7 FT)1857
(N15°W - 58.1 FT)1928
(S79°E - 53.5 FT)1928
(N38°E - 29.7 FT)1928
(S31°W - 87.8 FT)1928
(S45°E - 31.0 FT)1966
(N52°W - 38.0 FT)1966
(S51°W - 17.8 FT)1966

NEW CORNER ACCESSORIES:

NO NEW ACCESSORIES ADDED.

METHOD OF MEASUREMENT:
NO NEW MEASUREMENTS TAKEN.

CORNER MAINTENANCE/OTHER INFO:

CLEAR BRUSH FROM AROUND MONUMENT AND TO BT'S. TIE FLAGGING TO MONUMENT AND GUARD POSTS. PAINT BT FACES & A 6" BAND AT HEAD HEIGHT. ADD NEW NAILS TO EXISTING BT TAGS & ADD NEW TAGS WHERE NEEDED.

FILED AS A CONDITION REPORT.

GEODETTIC COORDINATES:

LATITUDE: N 42° 54' 07.296"
LONGITUDE: W 122° 55' 22.053"
ELLIPSOID HEIGHT: 1735 FT
DATUM: WGS 84

DOCUMENTS ON FILE AT:

3106 PIERCE PARKWAY, STE. D
SPRINGFIELD, OREGON 97477


SOURCE: CELL PHONE GPS. FOR NAVIGATION TO CORNER.

DATE OF INVESTIGATION: 6/15/2015

REPORT BY: JONATHAN B. DREW II, PLS#89396, CFedS#1664

ASSISTED BY: ANDREW HILLMAN, SURVEY TECH.

THIS DOCUMENT FILED IN CS OFFICE: YES
OTHER DOCUMENT FILED WITH CS: NONE

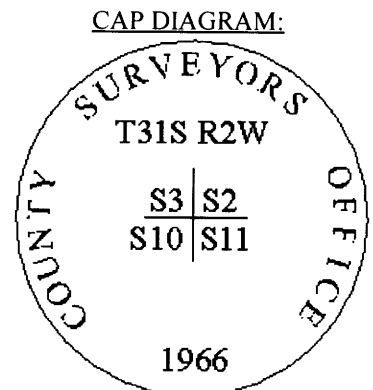

C.S. File No 65/90-48