

FS INDEX ID: E-22

CORNER INVESTIGATION REPORT

CORNER: W 1/16 GCDB ID: 620600 DATE: 6/17/2015
TOWNSHIP: 31S STATE: OREGON
RANGE: 2W COUNTY: DOUGLAS
SECTION: 1 & 12 FOREST: UMPQUA
MERIDIAN: W.M. DISTRICT: TILLER

NFSL PROPERTY BOUNDARY CORNER?: YES NO

LINE(S) POSTED: NORTH-1978 SOUTH-1978* WEST-1978 EAST-1978
MAINTAINED: NORTH-2015 SOUTH-NONE WEST-2015 EAST-NONE
GUARD POST(S): NORTH-4.2 FT SOUTH-4.1 FT WEST-3.1 FT EAST-NONE

CORNER HISTORY:

(1978)-ESTABLISHED WEST 1/16 CORNER, SETS BRASS CAP/IRON PIPE & 2 BT'S.
(1978*)-FINDS BRASS CAP/IRON PIPE & 2 BT'S.


MONUMENT FOUND/SET:

FOUND A 3" BRASS CAP ON 2-1/2" GALVANIZED IRON PIPE, PROJECTING 3 INCHES ABOVE A MOUND OF STONE, ON THE WEST SIDE AT THE BASE OF A LARGE CEDAR.

RECORD CORNER ACCESSORIES:

A 17" FIR WITH A HEALED DOUBLE BLAZE.
A 22" CEDAR WITH SCRIBE VISIBLE ON A PARTIALLY HEALED DOUBLE BLAZE.

REGISTERED
PROFESSIONAL
LAND SURVEYOR

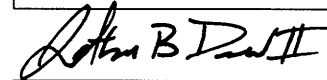

OREGON
DECEMBER 3, 2014
JONATHAN B. DREW II
89396

EXPIRES: 12/31/2015

RECORD MEASUREMENTS:

(N63°W - 10.5 FT)1978
(SOUTH - 22.5 FT)1978

FILED

Date: 8-25-2015 By: JC

This survey consists of:

Map: _____

Narrative: _____

Corner Rpt: CS 65/90-51

NEW CORNER ACCESSORIES:

NO NEW ACCESSORIES ADDED.

**DOUGLAS COUNTY
SURVEYOR**

METHOD OF MEASUREMENT:

NO NEW MEASUREMENTS TAKEN.

CORNER MAINTENANCE/OTHER INFO:

CLEAR BRUSH FROM AROUND MONUMENT AND TO BT'S. TIE FLAGGING TO MONUMENT AND GUARD POSTS, PAINT BT FACES & A 6" BAND AT HEAD HEIGHT, ADD NEW NAILS TO EXISTING BT TAGS & ADD NEW TAGS WHERE NEEDED.

FILED AS CONDITION REPORT.

GEODETTIC COORDINATES:

LATITUDE: N 42° 54' 06.909"
LONGITUDE: W 122° 53' 52.701"
ELLIPSOID HEIGHT: 2065 FT
DATUM: WGS 84

DOCUMENTS ON FILE AT:

3106 PIERCE PARKWAY, STE. D
SPRINGFIELD, OREGON 97477


SOURCE: CELL PHONE GPS, FOR NAVIGATION TO CORNER.

DATE OF INVESTIGATION: 6/17/2015

REPORT BY: JONATHAN B. DREW II, PLS#89396, CFedS#1664

ASSISTED BY: ANDREW HILLMAN, SURVEY TECH.

CAP DIAGRAM:

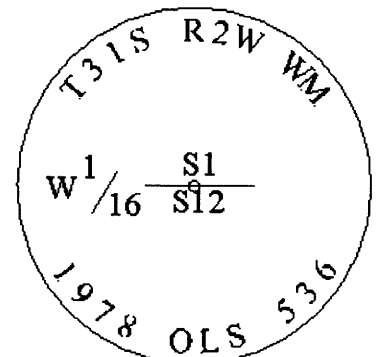

THIS DOCUMENT FILED IN CS OFFICE:

YES

OTHER DOCUMENT FILED WITH CS:

NONE

C.S. File No 65/90-51