

FS INDEX ID: N.19-9

CORNER INVESTIGATION REPORT

CORNER: 1/1024
TOWNSHIP: 31 S
RANGE: 1 W
SECTION: 20 & 21
MERIDIAN: W.M.
NFSL PROPERTY BOUNDARY CORNER?: YES NO

GCDB ID: 300373
STATE: OREGON
COUNTY: DOUGLAS
FOREST: UMPQUA
DISTRICT: TILLER

DATE: 6/17/2015

HISTORY OF VISITATIONS:

1972-J.A. HOFFBUHR, M42-75
 1978-G.S. BAUGHMAN, M70-28
 1978*-D. GAYLOARD, CS 60/17
 1981-J. LANDRUM-USFS CORNER CARD

LINE(S) POSTED: SOUTH-1978 WEST-1972
MAINTAINED: SOUTH-2015 WEST-NONE
GUARD POST(S): SOUTH-3.8 FT WEST-5.0 FT

CORNER HISTORY:

(1972)-ESTABLISHES 1/1024 CORNER. SETS BRASS CAP/IRON PIPE & 2 BT'S.
 (1978)-FINDS BRASS CAP/IRON PIPE & 2 BT'S. CAP & TREES MARKED 1/256 IN ERROR.
 (1978*)-FINDS BRASS CAP/IRON PIPE & 2 BT'S. RE-MARKS CAP & RE-SCRIBE TREE'S.
 (1981)-FINDS CORNER IN GOOD CONDITION.


MONUMENT FOUND/SET:

FOUND A 3" BRASS CAP ON 2-1/2" GALVANIZED IRON PIPE, PROJECTING 2 INCHES ABOVE A MOUND OF STONE.

RECORD CORNER ACCESSORIES:

A 12" FIR WITH A HEALED DOUBLE BLAZE.
 A 12" FIR WITH A HEALED DOUBLE BLAZE.

REGISTERED
 PROFESSIONAL
 LAND SURVEYOR

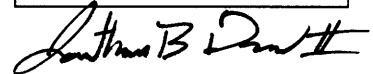

OREGON
 DECEMBER 3, 2014
 JONATHAN B. DREW II
 89396

EXPIRES: 12/31/2015

RECORD MEASUREMENTS:

(N36°30'E - 12.6 FT)1972
 (S62°30'W - 22.9 FT)1972

FILED

Date: 8-25-2015 By: JC

This survey consists of:

Map: _____

Narrative: _____

Corner Rpt: CS 65/90-54

DOUGLAS COUNTY
 SURVEYOR

NEW CORNER ACCESSORIES:

NO NEW ACCESSORIES ADDED.

METHOD OF MEASUREMENT:

TRIMBLE R6 RTK BASE & ROVER GPS
 NO NEW MEASUREMENTS TO BT'S.

CORNER MAINTENANCE/OTHER INFO:

CLEAR BRUSH FROM AROUND MONUMENT AND TO BT'S. TIE FLAGGING TO MONUMENT AND GUARD POSTS, PAINT BT FACES & A 6" BAND AT HEAD HEIGHT. ADD NEW NAILS TO EXISTING BT TAGS & ADD NEW TAGS WHERE NEEDED.

FILED AS A CONDITION REPORT.

GEODETIC COORDINATES:

LATITUDE: N 42° 52' 16.64726"
 LONGITUDE: W 122° 50' 36.46763
 ELLIPSOID HEIGHT: 2508.6 FT

DOCUMENTS ON FILE AT:

3106 PIERCE PARKWAY, STE. D
 SPRINGFIELD, OREGON 97477

DATUM: NAD_83(2011)(EPOCH:2010.0000)

SOURCE: DIRECT OCCUPATION, RTK & STATIC GPS. OPUS CORRECTED BASE.

DATE OF INVESTIGATION: 6/11/2015


REPORT BY: JONATHAN B. DREW II, PLS#89396, CFedS#1664

ASSISTED BY: ANDREW HILLMAN, SURVEY TECH.

THIS DOCUMENT FILED IN CS OFFICE: YES

OTHER DOCUMENT FILED WITH CS: NONE

CAP DIAGRAM:

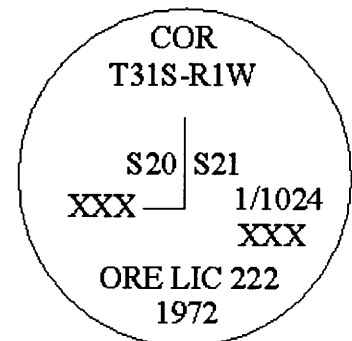

C.S. File No 65/90-54