

FS INDEX ID: V-17

CORNER INVESTIGATION REPORT

CORNER: SECTION GCDB ID: 500200 DATE: 6/9/2015
TOWNSHIP: 31S STATE: OREGON
RANGE: 1W COUNTY: DOUGLAS
SECTION: 26, 27, 34 & 35 FOREST: UMPQUA
MERIDIAN: W.M. DISTRICT: TILLER
NFSL PROPERTY BOUNDARY CORNER?: [X] YES [] NO
LINE(S) POSTED: SOUTH-1979 WEST-1975
MAINTAINED: SOUTH-2015 WEST-2014
GUARD POST(S): SOUTH-4.8 FT WEST-3.4 FT
CORNER HISTORY:

HISTORY OF VISITATIONS:
1857-DENNIS HATHORN, GLO SURVEY
1922-FRED MENSCH, GLO RESURVEY
1968-JOHN M. POWELL ET.AL, CS 54/71
1975-D.E. GARRETT, M58-7
1979-G.S. BAUGHMAN, USFS CNR. CARD
1985-L. MOFFIT, USFS CORNER CARD
2014-J. RANSOM/J. DREW, CS 65/85-23

(1857)-ESTABLISHED SECTION CORNER, SETS POST & 4 BT'S.
(1922)-FINDS 4 BT'S, SETS BRASS CAP/IRON PIPE.
(1968)-FINDS BRASS CAP/IRON PIPE & 4 BT'S, MARKS 2 NEW BT'S.
(1975)-FINDS BRASS CAP/IRON PIPE & 3 BT'S. (1979)-FINDS BC/IP & 6 BT'S.
(1985)-FINDS BC/IP & 6 BT'S. (2014)-FINDS BRASS CAP/IRON PIPE & 6 BT'S. 1 NEW BT.

MONUMENT FOUND/SET:

FOUND A 2-1/2" BRASS CAP ON 2" IRON PIPE, PROJECTING 6 INCHES ABOVE A MOUND OF STONE. PIPE LEANS SLIGHTLY SOUTHEAST. PAINT IRON PIPE RED TO PREVENT FURTHER RUSTING.

RECORD CORNER ACCESSORIES:

A 41" FIR WITH A HEALED DOUBLE BLAZE.
AN INDETERMINATE SIZE ROTTEN FIR STUMP WITH A HEALED FACE.
A ROOT HOLE WITH ROTTEN REMAINS OF FIR, NO MARKS.
A 43" FIR SNAG WITH A HEALED DOUBLE BLAZE.
A 37" FIR WITH A HEALED DOUBLE BLAZE.
A 26" FIR WITH A HEALED SINGLE BLAZE.
A 10" FIR WITH SCRIBE & WASHER VISIBLE ON A PARTIALLY HEALED DOUBLE BLAZE.

NEW CORNER ACCESSORIES:

NO NEW ACCESSORIES ADDED.

CORNER MAINTENANCE/OTHER INFO:

CLEAR BRUSH FROM AROUND MONUMENT AND TO BT'S. TIE FLAGGING TO MONUMENT AND GUARD POSTS, PAINT BT FACES & A 6" BAND AT HEAD HEIGHT, ADD NEW NAILS TO EXISTING BT TAGS & ADD NEW TAGS WHERE NEEDED.

GEODETIC COORDINATES:

LATITUDE: N 42° 50' 35.794"
LONGITUDE: W 122° 48' 13.279"
ELLIPSOID HEIGHT: 3640 FT
DATUM: WGS 84

DOCUMENTS ON FILE AT:

3106 PIERCE PARKWAY, STE. D
SPRINGFIELD, OREGON 97477

SOURCE: CELL PHONE GPS. FOR NAVIGATION TO CORNER.

DATE OF INVESTIGATION: 6/8/2015

REPORT BY: JONATHAN B. DREW II, PLS#89396, CFedS#1664

ASSISTED BY:

REGISTERED PROFESSIONAL LAND SURVEYOR

[Signature]

OREGON DECEMBER 3, 2014 JONATHAN B. DREW II 89396

EXPIRES: 12/31/2015

RECORD MEASUREMENTS:


(N50°W-40.0')1857, (N47°W-37.0')1975
(N30°E-23.8 FT)1857
(S38°W-7.3 FT)1857
(S10°E-25.1 FT)1857, (S3°E)1979
(N66°E-40.6 FT)1968
(S24°30'E-18.0 FT)1968
(S63°W-17.3 FT)2014

METHOD OF MEASUREMENT:

NO NEW MEASUREMENTS TAKEN.

FILED AS CONDITION REPORT.

CAP DIAGRAM:

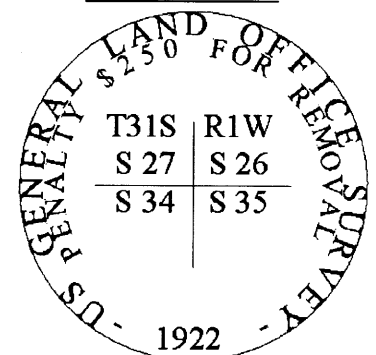

THIS DOCUMENT FILED IN CS OFFICE:

YES

OTHER DOCUMENT FILED WITH CS:

NONE

C.S. File No 65/90-61