

FS INDEX ID: X-15

CORNER INVESTIGATION REPORT

CORNER: C 1/4 GCDB ID: 440140 DATE: 6/9/2015
TOWNSHIP: 31S STATE: OREGON
RANGE: 1W COUNTY: DOUGLAS
SECTION: 34 FOREST: UMPQUA
MERIDIAN: W.M. DISTRICT: TILLER

NFSL PROPERTY BOUNDARY CORNER?: YES NO

LINE(S) POSTED: NORTH-1980 SOUTH-1980 EAST-1980 WEST-1980
MAINTAINED: NORTH-1992 SOUTH-2015 EAST-2015 WEST-1992
GUARD POST(S): NORTH-2.6 FT SOUTH-2.2 FT EAST-6.6 FT WEST-NONE

CORNER HISTORY:

(1980)-ESTABLISHED C1/4, SETS BRASS CAP/IRON PIPE & 2 BT'S.
(1992)-FINDS BRASS CAP/IRON PIPE & 2 BT'S.


MONUMENT FOUND/SET:

FOUND A 2-1/2" BRASS CAP ON 2-1/4" GALVANIZED IRON PIPE, PROJECTING 4 INCHES ABOVE THE GROUND.

RECORD CORNER ACCESSORIES:

A 15" FIR WITH A HEALED DOUBLE BLAZE.
A 19" FIR WITH A HEALED DOUBLE BLAZE.

REGISTERED
PROFESSIONAL
LAND SURVEYOR

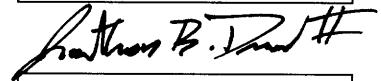

OREGON
DECEMBER 3, 2014
JONATHAN B. DREW II
89396

EXPIRES: 12/31/2015

RECORD MEASUREMENTS:

(S72°16'E - 28.0 FT)1980
(S9°45'W - 25.3 FT)1980

FILED

Date: 8-25-2015 By: JC

This survey consists of:

Map: _____

Narrative: _____

Corner Fpt. CS 65/90-62

DOUGLAS COUNTY
SURVEYOR

NEW CORNER ACCESSORIES:

NO NEW ACCESSORIES ADDED.

METHOD OF MEASUREMENT:


NO NEW MEASUREMENTS TAKEN.

CORNER MAINTENANCE/OTHER INFO:

FILED AS CONDITION REPORT.

CLEAR BRUSH FROM AROUND MONUMENT AND TO BT'S. TIE FLAGGING TO MONUMENT AND GUARD POSTS, PAINT BT FACES & A 6" BAND AT HEAD HEIGHT, ADD NEW NAILS TO EXISTING BT TAGS & ADD NEW TAGS WHERE NEEDED.

CAP DIAGRAM:

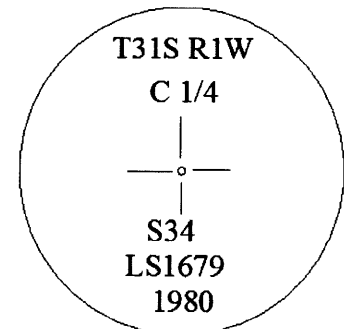

GEODETTIC COORDINATES:

LATITUDE: N 42° 50' 08.819"
LONGITUDE: W 122° 48' 50.213"
ELLIPSOID HEIGHT: 2920 FT
DATUM: WGS 84

DOCUMENTS ON FILE AT:

3106 PIERCE PARKWAY, STE. D
SPRINGFIELD, OREGON 97477

SOURCE: CELL PHONE GPS, FOR NAVIGATION TO CORNER.

DATE OF INVESTIGATION: 6/9/2015

REPORT BY: JONATHAN B. DREW II, PLS#89396, CFedS#1664

ASSISTED BY: ANDREW HILLMAN, SURVEY TECH.

THIS DOCUMENT FILED IN CS OFFICE: YES

OTHER DOCUMENT FILED WITH CS: NONE

C.S. File No 65/90-62