

FILED AUG 25 2015

FS INDEX ID: X-18

CORNER INVESTIGATION REPORT

CORNER: CW 1/16
TOWNSHIP: 30S
RANGE: 2W
SECTION: 35
MERIDIAN: W.M.

GCDB ID: 520140
STATE: OREGON
COUNTY: DOUGLAS
FOREST: UMPQUA
DISTRICT: TILLER

DATE: 7/7/2015

HISTORY OF VISITATIONS:

1978-G.S. BAUGHMAN, M65-56
1985-L. MOFFIT, USFS CORNER CARD
2009-USFS SURVEY CREW, NO RECORD

NFSL PROPERTY BOUNDARY CORNER?: YES NO

LINE(S) POSTED: SOUTH-1978 EAST-1978

MAINTAINED: SOUTH-2009 EAST-2015


GUARD POST(S): SOUTH EAST

CORNER HISTORY:

(1978)-ESTABLISHED CW 1/16 CORNER, SETS BRASS CAP/IRON PIPE & 2 BT'S.
(1985)-FINDS BRASS CAP/IRON PIPE & 2 BT'S.



Jonathan B. Drew II

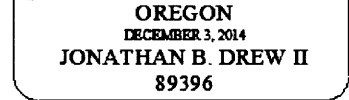

EXPIRES: 12/31/2015

RECORD MEASUREMENTS:

(N21°E-21.1 FT)1978

(N60°W-17.1 FT)1978

MONUMENT FOUND/SET:

FOUND A 3" BRASS CAP ON 2-1/2" GALVANIZED IRON PIPE, PROJECTING 6 INCHES ABOVE THE GROUND.

RECORD CORNER ACCESSORIES:

A ROOT HOLE BEARS. N14°45'E - 21.1 FT, A 20" WINDTHROW FIR WITH A HEALED SINGLE BLAZE LAYS NORTHEAST.
A 22" FIR STUMP BEARS. N57°15'W - 16.7 FT, WITH A HEALED SINGLE BLAZE.

NEW CORNER ACCESSORIES:

A 29" FIR BEARS. N57°15'E - 38.2 FT, MARKED "CW1/16S35" "BT" ON A DOUBLE BLAZE.
A 12" FIR BEARS. S58°30'E - 24.4 FT, MARKED "CW1/16S35" "BT" ON A DOUBLE BLAZE.


METHOD OF MEASUREMENT:

LEICA TCR 1201 TOTAL STATION
HOLD S89°52'18"E ON PROPERTY
LINE POST FOUND EAST OF CORNER.
BEARINGS TO CENTER, DISTANCES
TO NAIL SET SIDE CENTER.
GUARD POSTS PRESENT, NOT
MEASURED.

CORNER MAINTENANCE/OTHER INFO:

CLEAR BRUSH FROM AROUND MONUMENT AND TO BT'S. TIE FLAGGING TO MONUMENT AND GUARD POSTS, PAINT BT FACES & A 6" BAND AT HEAD HEIGHT, ADD NEW NAILS TO EXISTING BT TAGS & ADD NEW TAGS WHERE NEEDED.

CAP DIAGRAM:

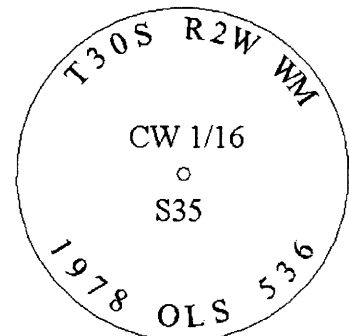

NEW BT'S INCLUDE A 3/4" BRASS WASHER "ORPLS#89396" NAILED BETWEEN B & T.

GEODETTIC COORDINATES:

LATITUDE: N 42° 55' 26.335"
LONGITUDE: W 122° 55' 03.773"
ELLIPSOID HEIGHT: 2470 FT
DATUM: WGS 84

DOCUMENTS ON FILE AT:

3106 PIERCE PARKWAY, STE. D
SPRINGFIELD, OREGON 97477

SOURCE: USGS QUAD MAP, FOR NAVIGATION TO CORNER.

DATE OF INVESTIGATION: 6/29/2015

REPORT BY: JONATHAN B. DREW II, PLS#89396, CFedS#1664

ASSISTED BY: ANDREW HILLMAN, SURVEY TECH.

THIS DOCUMENT FILED IN CS OFFICE: YES
OTHER DOCUMENT FILED WITH CS: NONE

C.S. File No 65/90-64