

FS INDEX ID: X-19

CORNER INVESTIGATION REPORT

CORNER: C 1/4
TOWNSHIP: 30S
RANGE: 2W
SECTION: 35
MERIDIAN: W.M.

GCDB ID: 540140
STATE: OREGON
COUNTY: DOUGLAS
FOREST: UMPQUA
DISTRICT: TILLER

DATE: 7/2/2015

HISTORY OF VISITATIONS:

1978-G.S. BAUGHMAN, M65-56
1985-L. MOFFIT, USFS CORNER CARD
2009-USFS SURVEY CREW, NO RECORD

NFSL PROPERTY BOUNDARY CORNER?: YES NO

LINE(S) POSTED: SOUTH-1978 WEST-1978

MAINTAINED: SOUTH-2009 WEST-2015

GUARD POST(S): SOUTH-3.3 FT WEST-3.2 FT

CORNER HISTORY:

(1978)-ESTABLISHED C 1/4 CORNER, SETS BRASS CAP/IRON PIPE & 2 BT'S.

(1985)-FINDS BRASS CAP/IRON PIPE & 2 BT'S.

REGISTERED
PROFESSIONAL
LAND SURVEYOR

OREGON
DECEMBER 3, 2014
JONATHAN B. DREW II
89396

MONUMENT FOUND/SET:

FOUND A 3" BRASS CAP ON 2-1/2" GALVANIZED IRON PIPE, PROJECTING 6" ABOVE THE GROUND.

EXPIRES: 12/31/2015

RECORD MEASUREMENTS:

(N44°E-13.8 FT)1978
(N25°W-20.7 FT)1978

RECORD CORNER ACCESSORIES:

A 39" CEDAR WITH A HEALED DOUBLE BLAZE.
A 30" CEDAR WITH A HEALED DOUBLE BLAZE.

FILED

Date: 8-25-2015 By: X

This survey consists of:

Map: _____

Narrative: _____

Corner Rpt: CS 65/90-65

NEW CORNER ACCESSORIES:

NO NEW ACCESSORIES ADDED.

**DOUGLAS COUNTY
SURVEYOR**

METHOD OF MEASUREMENT:

NO NEW MEASUREMENTS TAKEN.

CORNER MAINTENANCE/OTHER INFO:

CLEAR BRUSH FROM AROUND MONUMENT AND TO BT'S. TIE FLAGGING TO MONUMENT AND GUARD POSTS, PAINT BT FACES & A 6" BAND AT HEAD HEIGHT, ADD NEW NAILS TO EXISTING BT TAGS & ADD NEW TAGS WHERE NEEDED.

FILED AS CONDITION REPORT.


GEODETTIC COORDINATES:

LATITUDE: N 42° 55' 26.391"
LONGITUDE: W 122° 54' 46.105"
ELLIPSOID HEIGHT: 2415 FT
DATUM: WGS 84

DOCUMENTS ON FILE AT:

3106 PIERCE PARKWAY, STE. D
SPRINGFIELD, OREGON 97477

CAP DIAGRAM:

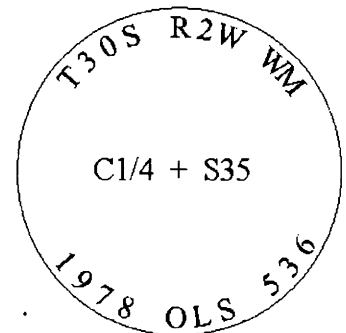

SOURCE: USGS QUAD MAP, FOR NAVIGATION TO CORNER.

DATE OF INVESTIGATION: 6/25/2015

REPORT BY: ANDREW HILLMAN, SURVEY TECH.

ASSISTED BY:

THIS DOCUMENT FILED IN CS OFFICE:

YES

OTHER DOCUMENT FILED WITH CS:

NONE

C.S. File No 65/90-65