

FS INDEX ID: Y-15

# CORNER INVESTIGATION REPORT

CORNER: CS 1/16  
TOWNSHIP: 31S  
RANGE: 1W  
SECTION: 34  
MERIDIAN: W.M.

GCDB ID: 440120  
STATE: OREGON  
COUNTY: DOUGLAS  
FOREST: UMPQUA  
DISTRICT: TILLER

DATE: 6/9/2015

HISTORY OF VISITATIONS:  
1980-K.C. WEAVER, M83-4A-D  
1992-K.O. DeGROOT, USFS CORNER CARD

NFSL PROPERTY BOUNDARY CORNER?:  YES  NO

LINE(S) POSTED: NORTH-1980 WEST-1980

MAINTAINED: NORTH-2015 WEST-1992

GUARD POST(S): NORTH-2.1 FT WEST-NONE

CORNER HISTORY:

1980-ESTABLISHED CS 1/16, SETS BRASS CAP/IRON PIPE & 2 BT'S.

1992-FINDS BRASS CAP/IRON PIPE & 2 BT'S.

REGISTERED  
PROFESSIONAL  
LAND SURVEYOR

OREGON  
DECEMBER 3, 2014  
JONATHAN B. DREW II  
89396

MONUMENT FOUND/SET:

FOUND A 2-1/2" BRASS CAP ON 2-1/4" GALVANIZED IRON PIPE, PROJECTING 5  
5 INCHES ABOVE THE GROUND.

EXPIRES: 12/31/2015

RECORD MEASUREMENTS:

(S51°09'E - 14.4 FT)1980

(S22°24'W - 11.0 FT)1980, (10.7 FT)1992

RECORD CORNER ACCESSORIES:

A 15" FIR WITH A HEALED DOUBLE BLAZE.  
A 12" FIR WITH A HEALED DOUBLE BLAZE.

FILED

Date: 8/25/2015 By: JC

This survey consists of:

Map: \_\_\_\_\_

Narrative: \_\_\_\_\_

Corner Rpt: CS 65/90-67

DOUGLAS COUNTY  
SURVEYOR

METHOD OF MEASUREMENT:

NO NEW MEASUREMENTS TAKEN.

NEW CORNER ACCESSORIES:


NO NEW ACCESSORIES ADDED.

FILED AS CONDITION REPORT.

CORNER MAINTENANCE/OTHER INFO:

CLEAR BRUSH FROM AROUND MONUMENT AND TO BT'S. TIE FLAGGING TO  
MONUMENT AND GUARD POSTS. PAINT BT FACES & A 6" BAND AT HEAD HEIGHT.  
ADD NEW NAILS TO EXISTING BT TAGS & ADD NEW TAGS WHERE NEEDED.

CAP DIAGRAM:

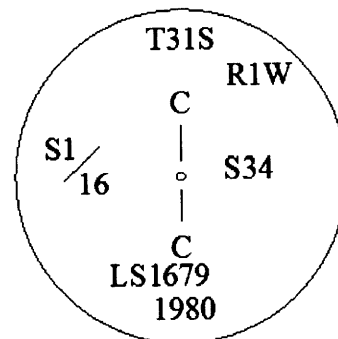

GEODETIC COORDINATES:

LATITUDE: N 42° 49' 56.359"  
LONGITUDE: W 122° 48' 49.931"  
ELLIPSOID HEIGHT: 2585 FT  
DATUM: WGS 84

DOCUMENTS ON FILE AT:

3106 PIERCE PARKWAY, STE. D  
SPRINGFIELD, OREGON 97477  
PHONE: (541)-225-6474

SOURCE: CELL PHONE GPS. FOR NAVIGATION TO CORNER.

DATE OF INVESTIGATION: 6/9/2015

REPORT BY: JONATHAN B. DREW II, PLS#89396, CFedS#1664

ASSISTED BY: ANDREW HILLMAN, SURVEY TECH.

THIS DOCUMENT FILED IN CS OFFICE:

YES

OTHER DOCUMENT FILED WITH CS:

NONE

C.S. File No 65/90-67