

FS INDEX ID: Z-18 & A-18

CORNER INVESTIGATION REPORT

CORNER: W 1/16 GCDB ID: 520100 & 520700 DATE: 7/7/2015
TOWNSHIP: 30S & 31S STATE: OREGON
RANGE: 2W COUNTY: DOUGLAS
SECTION: 35 & 2 FOREST: UMPQUA
MERIDIAN: W.M. DISTRICT: TILLER
NFSL PROPERTY BOUNDARY CORNER?: [x] YES [] NO

HISTORY OF VISITATIONS:
1978-G.S. BAUGHMAN, M65-56 & M65-68
2009-USFS SURVEY CREW, NO RECORD

LINE(S) POSTED: NORTH-1978 SOUTH-1978
MAINTAINED: NORTH-2009 SOUTH-2015
GUARD POST(S): NORTH-11.9FT SOUTH-2.8 FT
CORNER HISTORY:

(1978)-ESTABLISHED WEST 1/16 CORNER, SETS BRASS CAP/IRON PIPE & 2 BT'S.

REGISTERED PROFESSIONAL LAND SURVEYOR

Jonathan B. Drew II (handwritten signature)

OREGON DECEMBER 3, 2014 JONATHAN B. DREW II 89396

EXPIRES: 12/31/2015 RECORD MEASUREMENTS:

(S43°W-24.3 FT)1978
(N52°W-36.1 FT)1978

MONUMENT FOUND/SET:

FOUND A 2-1/2" BRASS CAP ON 2-1/2" GALVANIZED IRON PIPE, PROJECTING 2 INCHES ABOVE A MOUND OF STONE.

RECORD CORNER ACCESSORIES:

A 49" FIR BEARS, S47°30'W - 24.1 FT. WITH A HEALED DOUBLE BLAZE.
A ROOT HOLE BEARS, N49°45'W - 37.3 FT. WITH 22" FIR LOG TO SE, LAYS ON FACE

NEW CORNER ACCESSORIES:

A 9" FIR BEARS, N25°30'W - 18.6 FT. MARKED "W1/16S35BT" ON A SINGLE BLAZE.


METHOD OF MEASUREMENT:

LEICA TCRA 1103+ TOTAL STATION HOLD S0°06'10"W ON ALUM. POST FOUND 115.5 FT SOUTH OF CORNER. BEARINGS TO CENTER, DISTANCES TO NAIL SET SIDE CENTER.

CORNER MAINTENANCE/OTHER INFO:

CLEAR BRUSH FROM AROUND MONUMENT AND TO BT'S. TIE FLAGGING TO MONUMENT AND GUARD POSTS, PAINT BT FACES & A 6" BAND AT HEAD HEIGHT, ADD NEW NAILS TO EXISTING BT TAGS & ADD NEW TAGS WHERE NEEDED.

CAP DIAGRAM:

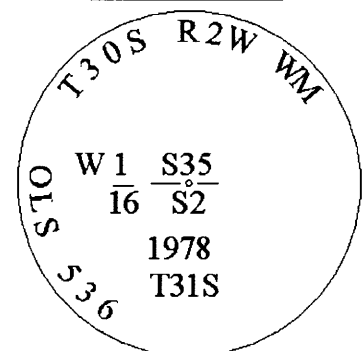

NEW BT INCLUDES 3/4" BRASS WASHER "ORPLS#89396" NAILED BETWEEN B & T
GEODETIC COORDINATES: DOCUMENTS ON FILE AT:

LATITUDE: N 42° 55' 00.183" 3106 PIERCE PARKWAY, STE. D
LONGITUDE: W 122° 55' 03.509" SPRINGFIELD, OREGON 97477
ELLIPSOID HEIGHT: 2265 FT
DATUM: WGS 84

SOURCE: CELL PHONE GPS, FOR NAVIGATION TO CORNER.

DATE OF INVESTIGATION: 6/16/2015

REPORT BY: JONATHAN B. DREW II, PLS#89396, CFedS#1664

ASSISTED BY: ANDREW HILLMAN, SURVEY TECH.

THIS DOCUMENT FILED IN CS OFFICE: YES
OTHER DOCUMENT FILED WITH CS: NONE

C.S. File No 65/90-68