

FS INDEX ID: G-8

CORNER INVESTIGATION REPORT

CORNER: CE 1/16 GCDB ID: 260540 DATE: 11/12/2015
TOWNSHIP: 20 S STATE: OREGON
RANGE: 11 W COUNTY: DOUGLAS
SECTION: 8 FOREST: SIUSLAW
MERIDIAN: W.M. DISTRICT: CENTRAL COAST

HISTORY OF VISITATIONS:
1961-WARREN D. HOOTMAN, M20-44
1982-GERALD K ATTIG, M91-20

NFSL PROPERTY BOUNDARY CORNER?: YES NO

LINE(S) POSTED: EAST-1982 SOUTH-1982

MAINTAINED: EAST-2015 SOUTH-1992

GUARD POST(S): EAST-3.0 FT SOUTH-2.2 FT

CORNER HISTORY:

(1961)-ESTABLISHED THE CE 1/16 CORNER, SETS A CAPPED PIPE & 2 BT'S.

(1982)-FINDS LEAD CAP, NO MENTION OF 1961 BT'S, SETS 2 NEW BT'S.

REGISTERED
PROFESSIONAL
LAND SURVEYOR

Jonathan B. Drew II
OREGON
DECEMBER 3, 2014
JONATHAN B. DREW II
89396

MONUMENT FOUND/SET:

FOUND A 3", OUTSIDE DIAMETER, LEAD FILLED IRON PIPE REDUCER ATTACHED TO A 1-1/4" IRON PIPE, PROJECTING 18 INCHES ABOVE THE GROUND.

EXPIRES: 12/31/2015

RECORD MEASUREMENTS:

(SOUTH - 11.0 FT)1961

(N42°W - 9.8 FT)1961

(N35°W - 7.3 FT)1982

(S20°W - 33.3 FT)1982

RECORD CORNER ACCESSORIES:

NO TRACE FOUND OF A (10" ALDER)1961

NO TRACE FOUND OF A (12" ALDER)1961

A ROTTEN 4" FIR LOG. WITH NO DISCERNIBLE ROOT HOLE AND NO MARKS VISIBLE.

A 41" FIR BEARS. S23°45'W - 32.1 FT. WITH A HEALED SINGLE BLAZE.

NEW CORNER ACCESSORIES:

A 8" FIR BEARS. N36°30'W - 20.7 FT. MARKED "CE1/16S8" "BT" ON A DOUBLE BLAZE.

NEW BT INCLUDES A 3/4" BRASS WASHER MARKED "ORPLS #89396" NAILED IN FACE BETWEEN "B" & "T" SCRIBE.

METHOD OF MEASUREMENT:

BEARINGS BASED ON TRAVERSE TIE EAST TO 1/4 CORNER S8 & S9.

BEING S89°37'18"E. PER DCSO M91-20.

EQUIPMENT: LEICA 1103+ TOTAL STATION. BEARINGS TO CENTER DISTANCES TO ALUMINUM NAIL SET AT SIDE CENTER.

CORNER MAINTENANCE/OTHER INFO:

CLEAR BRUSH FROM AROUND MONUMENT AND TO BT'S. TIE FLAGGING TO MONUMENT AND GUARD POSTS. PAINT BT FACES & A 6" BAND AT HEAD HEIGHT. ADD NEW NAILS TO EXISTING BT TAGS & ADD NEW TAGS WHERE NEEDED.

TRUE LINE POSTED WITH PROPERTY BOUNDARY SIGNS ATTACHED TO ALUMINUM POSTS FROM THIS CORNER TO 1/4 CORNER S8&S9. SEE CS SURVEY TO BE FILED.

GEODETIC COORDINATES:

LATITUDE: N 43° 50' 49.988"

LONGITUDE: W 124° 01' 53.049"

ELLIPSOID HEIGHT:

DATUM: WGS 84

SOURCE: CELL PHONE GPS. FOR NAVIGATION TO CORNER.

DATE OF INVESTIGATION: 11/11/2015

REPORT BY: JONATHAN B. DREW II. PLS#89396. CFedS#1664


ASSISTED BY: ANDREW HILLMAN. SURVEY TECH.

DOCUMENTS ON FILE AT:

3106 PIERCE PARKWAY, STE. D

SPRINGFIELD, OREGON 97477

CAP DIAGRAM:

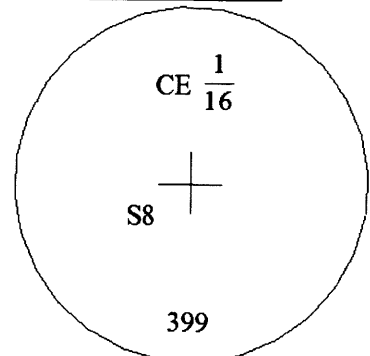

THIS DOCUMENT FILED IN CS OFFICE:

YES

OTHER DOCUMENT FILED WITH CS:

CS SURVEY

C.S. File No 65/90-74