

FS INDEX ID: G-9

CORNER INVESTIGATION REPORT

CORNER: 1/4 **GCDB ID:** 300540 **DATE:** 11/12/2015
TOWNSHIP: 20 S **STATE:** OREGON
RANGE: 11 W **COUNTY:** DOUGLAS
SECTION: 8 & 9 **FOREST:** SIUSLAW
MERIDIAN: W.M. **DISTRICT:** CENTRAL COAST
NFSL PROPERTY BOUNDARY CORNER?: YES NO

LINE(S) POSTED: WEST-1982 SOUTH-1975
MAINTAINED: WEST-2015 SOUTH-NONE
GUARD POST(S): WEST-4.2 FT SOUTH-7.1 FT

CORNER HISTORY:

(1891)-ESTABLISHED 1/4 CORNER, SETS POST & 2 BT'S.
(1948)-SHOWS CORNER AS FOUND.; (1961)-FINDS AN IRON PIPE & 2 BT'S.
(1970)-FINDS PIPE & 1 BT, SETS BRASS CAP/IRON PIPE & 1 NEW BT.
(1975)-FINDS BC/IP & 2 BT'S.; (1982)-FINDS BRASS CAP/IRON PIPE & 2 BT'S.
(2008)-FINDS BRASS CAP/IRON PIPE & 2 BT'S. SETS 2 NEW BT'S.

MONUMENT FOUND/SET:

FOUND A 2-1/2" BRASS CAP ON 2-1/4" GALVANIZED IRON PIPE, PROJECTING 3 INCHES ABOVE THE GROUND.

RECORD CORNER ACCESSORIES:

A 26" FIR STUMP WITH SCRIBE VISIBLE ON A PREV. OPENED SINGLE BLAZE.
NO TRACE FOUND OF A (6" FIR)1891. (FIR STUMP)1961
A 14" FIR STUMP WITH NO MARKS VISIBLE.
A 17" FIR WITH A HEALED DOUBLE BLAZE.
A 15" FIR WITH A HEALED DOUBLE BLAZE.
A 1-1/4" IRON PIPE BEARS, S40°E - 0.60 FT. PROJECTING 6 INCHES ABOVE GROUND.

NEW CORNER ACCESSORIES:

NO NEW ACCESSORIES ADDED.

CORNER MAINTENANCE/OTHER INFO:

CLEAR BRUSH FROM AROUND MONUMENT AND TO BT'S. TIE FLAGGING TO MONUMENT AND GUARD POSTS. PAINT BT FACES & A 6" BAND AT HEAD HEIGHT. ADD NEW NAILS TO EXISTING BT TAGS & ADD NEW TAGS WHERE NEEDED.

GEODETIC COORDINATES:

LATITUDE: N 43° 50' 49.768"
LONGITUDE: W 124° 01' 35.241"
ELLIPSOID HEIGHT:
DATUM: WGS 84

DOCUMENTS ON FILE AT:

3106 PIERCE PARKWAY, STE. D
SPRINGFIELD, OREGON 97477

SOURCE: CELL PHONE GPS. FOR NAVIGATION TO CORNER.

DATE OF INVESTIGATION: 11/10/2015

REPORT BY: JONATHAN B. DREW II, PLS#89396, CFedS#1664

ASSISTED BY: ANDREW HILLMAN, SURVEY TECH.

HISTORY OF VISITATIONS:
1891-W.M. THIEL, GLO SURVEY
1948-H.P. MILLER, M24-52
1961-WARREN D. HOOTMAN, M20-44
1963-W.D. HOOTMAN, M24-52, CS 51/249
1970-TOM McCULLOUGH, CS 55/142
1975-RONALD E. STUNTZNER, M55-76
1982-GERALD K ATTIG, M91-20
2008-K.O. DeGROOT, M157-6

REGISTERED
PROFESSIONAL
LAND SURVEYOR

Jonathan B. Drew II
OREGON
DECEMBER 3, 2014
JONATHAN B. DREW II
89396

EXPIRES: 12/31/2015

RECORD MEASUREMENTS:

(S74°W-4.6 FT)1891,1961,1970,1975,1982
(S42°E-7.3 FT)1891 & 1961
(N50°E - 35.0 FT)1970, 1975 & 1982
(S30°15'W - 26.6 FT)2008
(N60°45'E - 20.1 FT)2008
(ALONGSIDE)2008


METHOD OF MEASUREMENT:

NO NEW MEASUREMENTS TO BT'S.

FILED AS CONDITION REPORT.

BEARING TO FOUND IRON ROD BY
HAND COMPASS, DISTANCE BY
STEEL TAPE

CAP DIAGRAM:

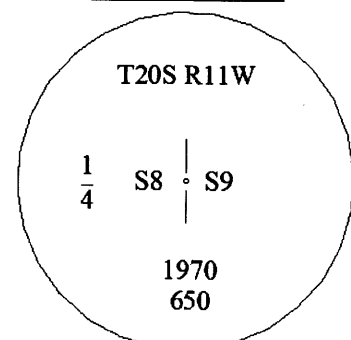

THIS DOCUMENT FILED IN CS OFFICE: YES
OTHER DOCUMENT FILED WITH CS: CS SURVEY

C.S. File No 65/90-75