

5/8" Iron Rod with 2 1/2"
Aluminum Cap Marked "Lone
Rock Timber CN 1/16 S13 2007
PLS 2291"

2009-0035
Parcel 2

2009-0035
Parcel 1

(N88° 11' 14"W 2690.68')
N88° 11' 14"E 2690.68'

1869.14'
(1869.14')

S00° 13' 17"W 946.95'
(S00° 13' 17"W 946.95')

821.54'
(821.54')

N85° 46' 54"E 207.05'
(N85° 46' 54"E 207.05')

418.56'
S13° 57' 08"E 475.56'
(S13° 57' 08"E 475.56')

FILED

Date: 4-4-2016 By: JC
This survey consists of:
Map: CS 65/92-4
Narrative: _____
Corner Rpt: _____

**DOUGLAS COUNTY
SURVEYOR**

LEGEND:

- ◆ Found Brass Cap unless noted.
 - Set 5/8" x 30" reinforcing rod with YPC marked "LAND MARK PLS2287".
 - 47" Douglas Fir
 - Calculated Point
- YPC - Yellow Plastic Cap

RECORD INFORMATION

() 2009-0035

Narrative:


The purpose of this survey is to monument certain corners as designated by the client of the boundary of Parcel 1 of the Unsurveyed Partition No. 2009-0035.

Monuments were set at record bearings and distances using original control.

Basis of Bearing, Oregon State Plane Coordinate System, South Zone. North American Datum of 1983, EPOCH 2010.00

Reference Station: "STEAM"
LAT. 43°20'36.73420" NORTH
LON. 122°44'17.74910" WEST

GRAPHIC SCALE

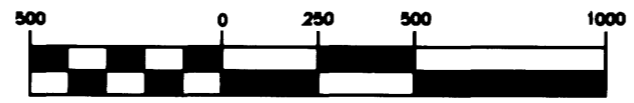

(IN FEET)
1 inch = 500 ft.

**REGISTERED
PROFESSIONAL
LAND SURVEYOR**

Mark A. Heimbürger

OREGON
JULY 16, 1987
MARK A. HEIMBURGER
2287

RENEWS JUNE 30, 2017

RECORD OF SURVEY

In the NE 1/4 and SE 1/4 Section 13
Township 26 South, Range 2 West, W.M.
Douglas County, Oregon
March, 2016

FOR: Bruce Goforth
P.O. Box 211
Idleld, Oregon 97471
LM Proj. No. 2016-0013

**Land Mark
SURVEYING INC.**
3329 N.E. Stephens Street
Roseburg, Oregon 97470
Tel (541) 677-9400
Fax (541) 677-9401

Sheet 1 of 1

C.S. File No 65/92-4