


RECORD OF SURVEY
 FOR: SENECA JONES TIMBER CO.
 NW1/4, SEC. 22, T27S, R03W, W.M.
 DOUGLAS COUNTY, OREGON

NARRATIVE
 THIS SURVEY WAS PERFORMED IN 2001.
 SENECA JONES TIMBER CO. HAS ASKED THAT
 WE FILE A SURVEY DOCUMENTING THE LINE
 THAT WAS POSTED AND BLAZED. WHEN THE
 SURVEY WAS PERFORMED IN 2001, A RECORD
 OF SURVEY WAS NOT FILED BECAUSE NO
 CORNERS WERE SET.


FILED
 DATE: 4-27-2016 BY: JC
 THIS SURVEY CONSISTS OF:
 MAP: CS 65/92-5
 NARRATIVE: _____
 CORNER RPT: _____
 DOUGLAS COUNTY
 SURVEYOR

THE BASIS OF BEARING WAS AS NOTED.

THIS SURVEY WAS PERFORMED USING A
 NIKON TOTAL STATION.

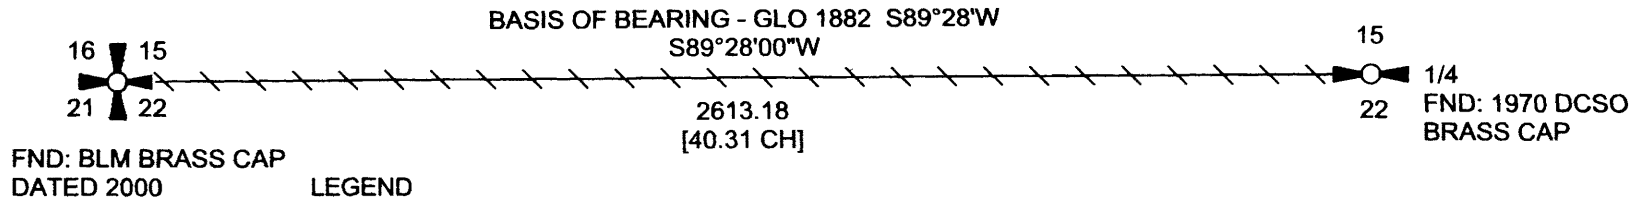

LEGEND

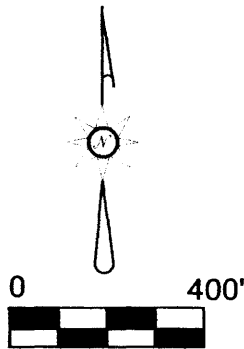

- FOUND MONUMENT AS NOTED
- FOUND MONUMENT AS NOTED
- LINE BLAZED, PAINTED WITH RED PAINT,
 RIBBONED WITH RED FLAGGING AND POSTED
 WITH 5-1/2' GALVANIZED STEEL FENCE POSTS
 SET AT AN INTERVAL OF +/- 200'
- CH CHAINS
- DCSO DOUGLAS COUNTY SURVEYOR
 OFFICE
- GLO GENERAL LAND OFFICE
- BLM BUREAU OF LAND MANAGEMENT

REGISTERED
 PROFESSIONAL
 LAND SURVEYOR

Robert B. Ward Jr.

OREGON
 ROBERT B. WARD JR.
 JULY 30, 1976
 LS 1091

EXPIRATION DATE: 6/30/16

FILE NAME		
16-041.trv		
SCALE	DATE	DRAWN BY
400 Ft/In	3-30-2016	RBW
JOB	REVISION	SHEET
16-041	----	1/1

This map drawn with TRAVERSE PC, Software

NORTHWEST Land Surveying, Inc.

(541) 997-9201
 www.northwestlandsurveying.com

P.O. Box 2827
 Florence, OR 97439
 Fax (541) 902-0743

C.S. File No 65/92-5