

# MAP OF SURVEY

LOCATED in the NW 1/4 of  
Sec. 11, T. 30 S., R. 9 W., W.M.  
in Douglas County, Oregon.

July 15, 2016

FILED

Date: 7-27-2016 By: X

This survey consists of:

Map: CS 65/92-13

Narrative: \_\_\_\_\_

Corner Rpt: \_\_\_\_\_

DOUGLAS COUNTY  
SURVEYOR

**SURVEYED FOR:** *SENECA JONES TIMBER COMPANY*  
*P.O. BOX 2129*  
*ROSEBURG, OREGON 97470*

**SURVEYED BY:** *DAVID EDWARDS LAND SURVEYING*  
*P.O. BOX 361*  
*OAKLAND, OREGON 97462*  
*PHONE: (541) 459-0512*

REGISTERED  
PROFESSIONAL  
LAND SURVEYOR

*David A. Edwards*

OREGON  
JULY 26, 1988  
DAVID A. EDWARDS  
2339  
RENEWS 12/31/17

## LEGEND

● INDICATES DOUGLAS COUNTY SURVEYOR BRASS CAPPED IRON PIPE FOUND.

○ INDICATES 5/8" X 30" STEEL REBAR WITH 2 1/2" DIAM. ALUMINUM  
CAP MARKED "WIT. MON." & "S11" & "LS 2339" & "2016".

( ) DENOTES RECORD DATA PER M 49-51.

SCALE: 1" = 500'

BASIS OF BEARINGS: M 49-51 AS SHOWN.

COMP. = COMPUTED

## NARRATIVE


THE PURPOSE OF THIS SURVEY IS TO MARK A PORTION OF THE NORTH LINE OF THE NW QUARTER OF SECTION 11. A RANDOM TRAVERSE WAS RUN BETWEEN THE 1/4 CORNER AND THE M 49-51 BEARING TREES AND A POSITION WAS COMPUTED FOR THE WEST 1/16 CORNER, WHICH FALLS IN THE RIVER. OFFSETS WERE THEN MADE TO THE TRUE LINE. THE LINE WAS MARKED BY BLAZING TREES ON EACH SIDE OF LINE, BY SETTING SIX FOOT STEEL POSTS ALONG THE LINE AT INTERVALS OF 200 FEET OR LESS AND BY HANGING LIBERAL AMOUNTS OF RED FLAGGING ALONG THE TRUE LINE. FROM THE SET WITNESS MONUMENT: A 9" DIAM. FIR SCRIBED "WM S11 BT" BEARS S 56° E, 8.4 FEET.

A 6 FOOT STEEL POST IS SET 2 FEET EAST.


FIELD CREW: BRANT MILLER AND ERIC SPRINKLE.

EQUIPMENT: NIKON TOTAL STATION.

COMPUTATIONS AND DRAFTING: DAVID EDWARDS.

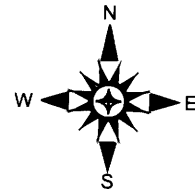

SET WIT. MON. S 89°59'00" E, 14.68'  
FROM WEST 1/16 CORNER COMP.  
FROM M 49-51 BEARING TREES:  
40" DIAM. CEDAR STUMP BEARS S 15° E, 36.0'  
44" DIAM. CEDAR BEARS N 46° E, 96.5'  
M 49-51 MONUMENT IS IN THE  
MIDDLE FORK OF THE COQUILLE RIVER.

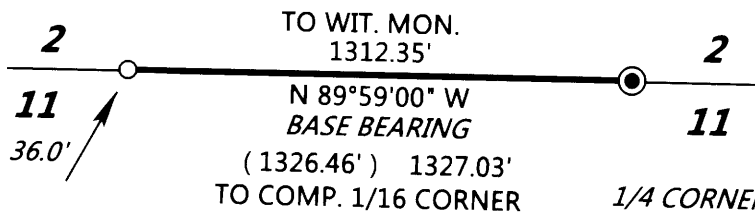

1/4 CORNER FOUND  
AS PER M 152-28.