

FILED  
Date: 2/24/2016 By: JC  
This survey consists of:  
Map: \_\_\_\_\_  
Narrative: \_\_\_\_\_  
Corner Rpt: CS 65/93-1

CORNER REPORT FORM

Section 18 Township 28 S Range 3 W  
Douglas County Date Jan. 19, 2016  
PLSS Number 140500

DOUGLAS COUNTY  
SURVEYOR

CORNER DESIGNATION

1/4 corner common to  
Sections 7 and 18.

- \_\_\_ Condition Report only
- \_\_\_ Not Found
- Renewed
- \_\_\_ Unrecorded
- \_\_\_ Surveyed In
- \_\_\_ Referenced out

Previous Renewals/Surveys, etc:

This corner was set by the proportion  
method by the B.L.M. in 1972.

Monument(s) & Accessories Found: (Condition and Source)

Found standard B.L.M. rock cap firmly set on small rock outcrop.  
The NE B.L.M. B.T. falls in the power line clearing and is gone.  
The SW B.L.M. B.T. is also gone.

Monument Detail

Sketch

N/A

Monument Set (Procedures and Description)


N/A

New Accessories

A 19" diam. Fir bears N. 29° E., 15.6 feet.  
A 16" diam. Fir bears N. 59° W., 18.4 feet. Both scribed "1/4 S7 BT"  
No trees within a reasonable distance in Section 18.  
A six foot steel post is set 3 feet North. Surveyor's Seal

Location & Comments

Compass Declination 15° East  
Firm/Agency: David Edwards Land Surveying  
Address: P.O. Box 361  
Oakland, Oregon 97462  
Party Chief: Brant Miller  
Notes: \_\_\_\_\_  
Witness: Eric Sprinkle

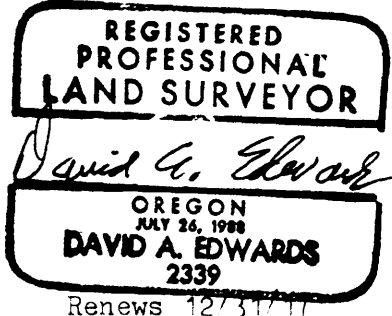

C.S. File 65/93-1