

FS INDEX ID: E-11

CORNER INVESTIGATION REPORT

CORNER: 1/4 GCDB ID: 340600 DATE: 4/7/2016
TOWNSHIP: 20S STATE: OREGON
RANGE: 11W COUNTY: DOUGLAS
SECTION: 4 & 9 FOREST: SIUSLAW
MERIDIAN: W.M. DISTRICT: CENTRAL COAST
NFSL PROPERTY BOUNDARY CORNER?: [x] YES [ ] NO

HISTORY OF VISITATIONS:
1892-W.M. THIEL, GLO SURVEY
1975-R.E. STUNTZNER, M55-76
2003-R. RICE, CS 65/48-33

LINE(S) POSTED: EAST-1975 WEST-1975
MAINTAINED: EAST-NONE WEST-2016
GUARD POST(S): EAST- 0.6 FT WEST- 0.5 FT

CORNER HISTORY:

(1892)-ESTABLISHED CORNER. SETS STONE & MOUND OF STONE ALONGSIDE.
(1975)-FINDS NO EVIDENCE, SETS BRASS CAP/IRON PIPE AT PROPORTION BY SURVEY AND MARKS 2 NEW BT'S.
(2003)-FINDS BRASS CAP/IRON PIPE & 2 BT'S. MARKS 4 NEW BT'S.

MONUMENT FOUND/SET:

FOUND A 2-1/2" IRON PIPE WITH A 3" BRASS CAP. PROJECTING 6 INCHES ABOVE GROUND.

NOTE: A SEARCH WAS MADE FOR THE ORIGINAL CORNER AND NO EVIDENCE WAS RECOVERED.

RECORD CORNER ACCESSORIES:

NO TRACE FOUND OF A (MOS 1.5'H & 2"W. ALONGSIDE STONE)
A 42" FIR HIGH STUMP BEARS. N61°52'E - 19.1 FT. WITH SCRIBE FRAGMENTS VISIBLE.
A 18" FIR HIGH STUMP BEARS. S8°44'E - 12.2 FT. WITH NO MARKS VISIBLE.
A 16" TWIN HEMLOCK BEARS. S68°44'E - 16.8 FT. WITH SCRIBE VISIBLE ON A PARTIALLY HEALED SINGLE BLAZE.
A 9" FIR BEARS. S40°08'E - 13.6 FT. WITH A HEALED SINGLE BLAZE.
A 14" FIR BEARS. N11°50'W - 4.3 FT. WITH A HEALED SINGLE BLAZE.
A 15" FIR BEARS. N52°51'E - 9.0 FT. WITH A HEALED SINGLE BLAZE.

REGISTERED PROFESSIONAL LAND SURVEYOR

JONATHAN B. DREW II
OREGON
DECEMBER 3, 2014
JONATHAN B. DREW II
89396

EXPIRES: 12/31/2017

RECORD MEASUREMENTS:

(ALONGSIDE)1892
(N63°E - 18.8 FT)1975 & 2003
(S9°E - 12.0 FT)1975 & 2003
(S70°E - 16.9 FT)2003
(S36°E - 13.6 FT)2003
(N11°W - 4.3 FT)2003
(N53°E - 9.0 FT)2003


NEW CORNER ACCESSORIES:

NO NEW ACCESSORIES ADDED.

METHOD OF MEASUREMENT:

LEICA TCRA 1103+ TOTAL STATION.
BT BEARINGS ARE MEAN GEODETIC TO CENTER & DISTANCES TO AN ALUMINUM NAIL SET AT SIDE CENTER. TIES MADE FROM A CLOSED TRAVERSE TIED TO GEODETIC CONTROL.

CAP DIAGRAM:

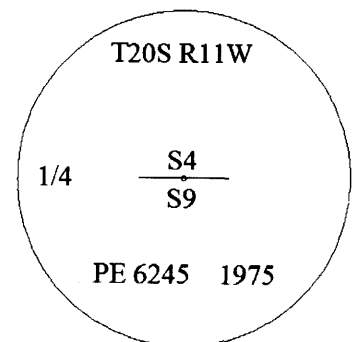

CORNER MAINTENANCE/OTHER INFO:

CLEAR BRUSH FROM AROUND MONUMENT AND TO BT'S. TIE FLAGGING TO MONUMENT AND GUARD POSTS. PAINT BT FACES & A 6" BAND AT HEAD HEIGHT. ADD NEW NAILS TO EXISTING BT TAGS & ADD NEW TAGS WHERE NEEDED.

NOTE: WEST GUARD POST NOTED IS A RUSTED OFF GARDEN STYLE FENCE POST.

A NEW GUARD POST WAS SET TO THE WEST BUT WAS NOT MEASURED.

GEODETIC COORDINATES:

LATITUDE: N 43° 51' 19.65762"
LONGITUDE: W 124° 00' 58.02362"
ELLIPSOID HEIGHT: 817 FT

DOCUMENTS ON FILE AT:

3106 PIERCE PARKWAY, STE. D
SPRINGFIELD, OREGON 97477

DATUM: NAD83(2011) EPOCH:(2010.0000)

SOURCE: TRAVERSE TIE FROM OPUS CORRECTED GEODETIC CONTROL.

DATE OF INVESTIGATION: 3/22/2016

REPORT BY: JONATHAN B. DREW II, PLS#89396, CFedS#1664

ASSISTED BY: ANDREW HILLMAN, SURVEY TECH.
LANCE GOUCHER, SURVEY TECH.

THIS DOCUMENT FILED IN CS OFFICE: YES
OTHER DOCUMENT FILED WITH CS: CS SURVEY

C.S. File No 65/93-3