

FILED

Date: 8-2-2016 By: SC

This survey consists of:

Map: _____

Narrative: _____

Corner Rpt: CS 65/93-26

DOUGLAS COUNTY
SURVEYOR

PAGE 1 OF 2

LANE COUNTY SURVEYORS OFFICE
DEPARTMENT OF PUBLIC WORKS

FILE NO: 19-09-05 S1/4

TRGCDB: 1909240600

INDEX NO: **16177**

CORNER REPORT

THE 1/4 CORNER COMMON TO SECTIONS 5 AND 8, T19S, R9W, W. M.
LOCATED ON THE LANE - DOUGLAS COUNTY LINE

DATE	1899	1958	1983	1991
SURVEYOR	H. CHANDLER	T. TILLMAN	R. STUNTZER	D. BAKER
SOURCE	GLO VOL R434, PG 568	BLM VOL R573, PG 414	CSF 26183-26185	CSF 30283
MONUMENT FOUND		NO EVIDENCE OF ORIG. CORNER	B.L.M. I.P. AND BRASS CAP	BLM BC
MONUMENT SET	9" HEMLOCK, DULY MARKED	2 1/2" x 28" IRON POST W/ BRASS CAP BY PROPORTION		
BEARING OBJECT 1	7" HEMLOCK, W/ MKS S 45° E, 10 LKS = 6.6'			
BEARING OBJECT 2	7" HEMLOCK W/ MKS N 85° W, 12 LKS = 7.9'			
BEARING OBJECT 3		32" FIR MKD "1/4 S8 BT" S 28 1/4° E, 74 LKS = 48.8'	40" D. FIR, W/ HEALED FACE S 28° E, 49.5'	42" FIR S 28° E, 49.5'
BEARING OBJECT 4		22" ALDER "1/4 S5 BT" N 64° W, 84 LKS = 55.4'	21" ALDER W/ MARKS N 64° W, 55.3'	18" ALDER N 64° W, 55.3'

(BOLDDED ENTRIES IN THE ABOVE HISTORY TABLE WERE FOUND AND ARE FURTHER DESCRIBED.)

CORNER EVIDENCE

EVIDENCE RECOVERED: AT THE CORNER POSITION FOUND A 3-1/4" BLM BRASS CAP ATOP A 2-1/2" IRON POST, 4" ABOVE GROUND.

ACCESSORIES FOUND AND ESTABLISHED: SEE SKETCH ON PAGE 2 FOR TIES AND DESCRIPTIONS.

MONUMENT SET: NONE. ACCEPTED THE FOUND BRASS CAP AS MARKING THE 1/4 CORNER POSITION.

OTHER INFORMATION

BEARING TREES: DISTANCE SHOWN IS TO AN ALUMINUM NAIL SET AT SIDE/CENTER OF LIVE TREES.

BASIS OF BEARING: N 64° W FROM BRASS CAP TO 1958 [4].

GEOGRAPHIC MAP LOCATION: FOR FINDING THE CORNER AREA - NOT OF SURVEY GRADE ACCURACY
NAD 83/91 VALUES: LATITUDE: N 43° 56' 39.7" LONGITUDE: W 123° 47' 51.2"

EQUIPMENT USED: W-K COMPASS #23157 AND STEEL TAPE.

DATE OF SURVEY: SEPTEMBER 16, 2015


FIELD WORK BY: BRUCE BOTHEL, PLS, ASSOCIATE SURVEYOR **BB**
STUART DUCE, PLS, ENGINEERING TECHNICIAN II

C.S. File No 65/93-26
(*)

LANE COUNTY SURVEYORS OFFICE
DEPARTMENT OF PUBLIC WORKS

FILE NO: 19-09-05 S1/4
TRGCDB: 1909240600
INDEX NO: 16177

1958 [4]
19" ALDER W/
BARK SCRIBES
N 64° W, 55.8'
TO CENTER

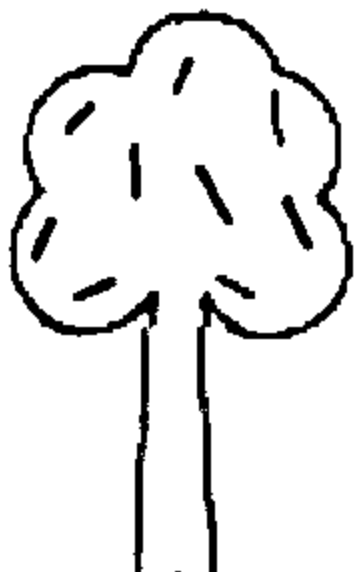


T I M B E R

2015 [5]
10" HEMLOCK
MKD "CSBT"
N 28 1/2° E, 27.2'
TO CENTER



FOUND BRASS CAP

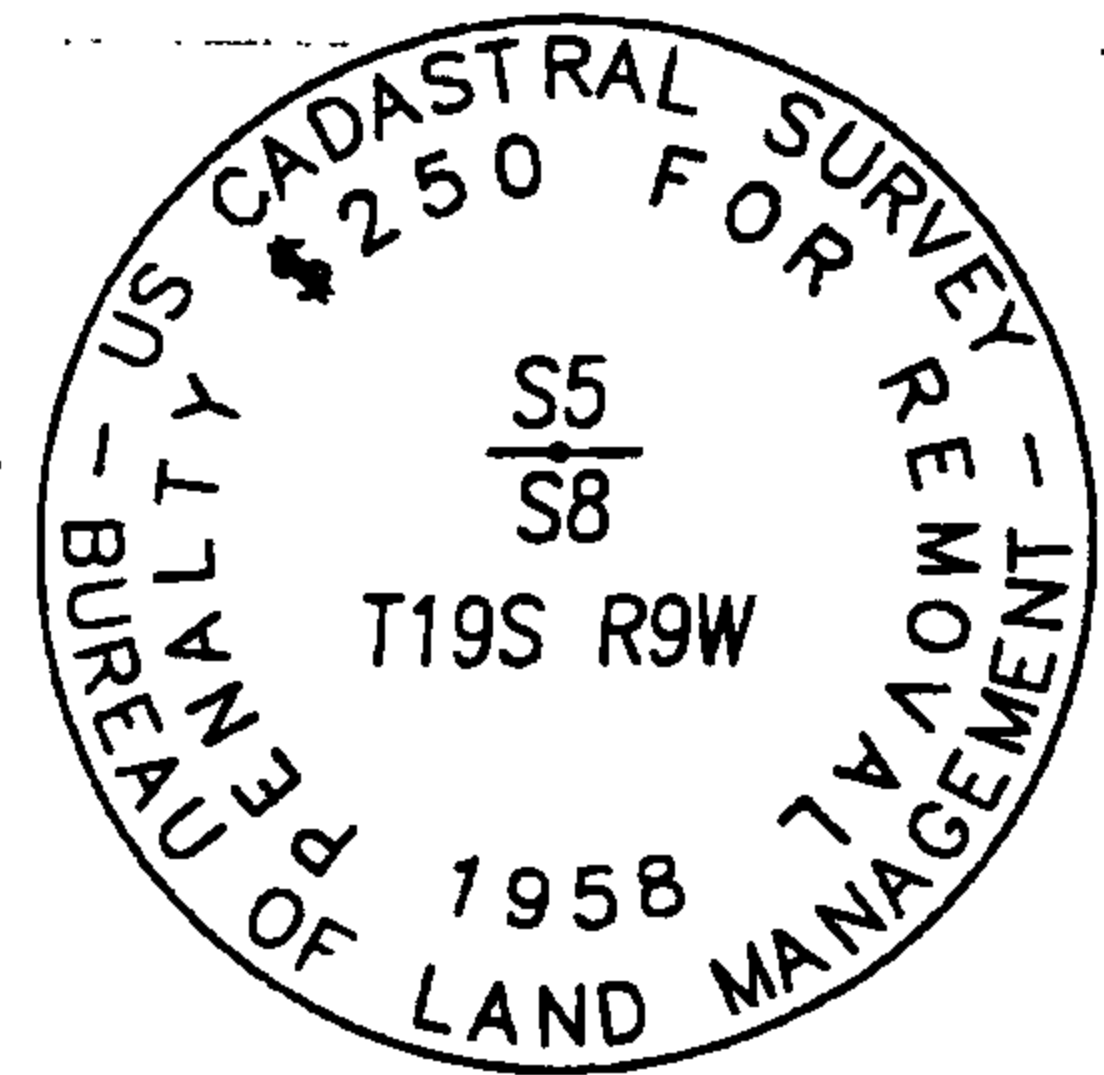

2015 [6]
12" HEMLOCK
MKD "CSBT"
S 84° W, 23.0'
TO CENTER



NO SCALE

REGISTERED
PROFESSIONAL
LAND SURVEYOR
[Signature]
OREGON
JUNE 13, 2008
MIKEAL J. BLOMME'
74387
EXPIRES DEC 31, 2015

1958 [3]
46" FIR W/
HEALED FACE
S 28 1/4° E, 49.1'
TO CENTER

