

FILED
DATE: 11-8-2016 BY: X
THIS SURVEY CONSISTS OF:
MAP: _____
NARRATIVE: _____
CORNER RPT: CS 65/93-35
DOUGLAS COUNTY SURVEYOR

FS INDEX ID: G-25 & G-1 **CORNER INVESTIGATION REPORT**


CORNER: 1/4 **GCDB ID:** 700540 & 100540 **DATE:** 9/13/2016
TOWNSHIP: 31 S **STATE:** OREGON
RANGE: 2W & 1W **COUNTY:** DOUGLAS
SECTION: 12 & 7 **FOREST:** UMPQUA
MERIDIAN: W.M. **DISTRICT:** TILLER

HISTORY OF VISITATIONS:
1857 - DENNIS HATHORN, GLO SURVEY
1950 - A. BOYER, CS 40/298
1966 - J. POWELL, ET AL., CS 54/28
1967 - G.S. BAUGHMAN, M 34-23
1978 - L. MOFFIT, M 70-26
1980 - L. HERZSTEIN, CS 61/11
2003 - L. HERZSTEIN, BLM RESURVEY

NFSL PROPERTY BOUNDARY CORNER?: YES NO

LINE(S) POSTED: NORTH-1967 WEST-1978
MAINTAINED: NORTH-2016 WEST-2016
GUARD POST(S): NORTH-3.3 FT WEST-2.7 FT

CORNER HISTORY:
(1857) - ESTABLISHED CORNER, SETS POST & 2 BT'S.
(1950) - FINDS NO EVIDENCE, MARKS TREE AT PROPORTION POSITION & 2 BT'S.
(1966) - FINDS CORNER TREE & 2 BT'S, SETS BC/IP ALONGSIDE & MARKS 1 NEW BT.
(1967) - FINDS BRASS CAP/IRON PIPE & 2 BT'S.
(1978) - FINDS BRASS CAP/IRON PIPE & 3 BT'S.
(1980) - RE-ESTABLISHED CORNER FROM 2 FOUND ORIGINAL BT'S, SETS BC/IP.
(2003) - ACCEPTS 1980 CORNER POSITION, FINDS BC/IP &

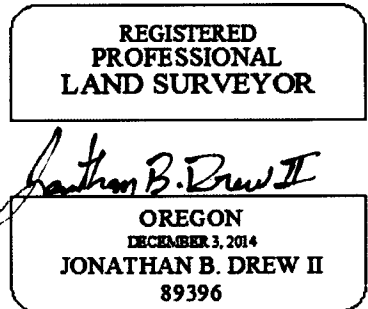

MONUMENT FOUND/SET:
FOUND A 1-1/4" GALVANIZED IRON PIPE WITH A 2-1/2" BRASS CAP, PROJECTING 4 INCHES ABOVE THE GROUND.

EXPIRES: 12/31/2017
RECORD MEASUREMENTS:
(N12°W-23.1 FT)1857 & 2003
(N57°E - 20.5 FT)1857, (19.6 FT)2003
(S6°E - 7.5 FT)1980
(S10°E - 7.9 FT)1980

(N81°45'E - 11.3 FT)1980
(N85°W - 7.4 FT)1980
(N0°15'E - 18.6 FT)1980


RECORD CORNER ACCESSORIES:
A 36" FIR WITH A PREVIOUSLY OPENED DOUBLE FACE.
A 37" FIR WITH A PREVIOUSLY OPENED FACE.
A 8" MAPLE WITH HEALED QUARTER BLAZES.
A 1-1/4" GALVANIZED IRON PIPE WITH A 2-1/2" BRASS CAP, PROJECTING 12" ABOVE THE GROUND, WITH MARKINGS OBLITERATED.
A 11" FIR WITH A HEALED SINGLE BLAZE.
A 7" MAPLE WITH A HEALED DOUBLE BLAZE.
A 28" FIR WITH A HEALED DOUBLE BLAZE.

METHOD OF MEASUREMENT:
NO NEW MEASUREMENTS TAKEN.

FILED AS CONDITION REPORT.

NEW CORNER ACCESSORIES:
NO NEW ACCESSORIES ADDED.

CORNER MAINTENANCE/OTHER INFO:
CLEAR BRUSH FROM AROUND MONUMENT AND TO BT'S. TIE FLAGGING TO MONUMENT AND GUARD POSTS, PAINT BT FACES & A 6" BAND AT HEAD HEIGHT,

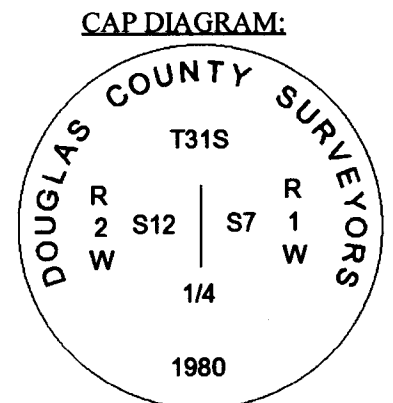

ALL RECORD MEASUREMENTS SHOWN TO 1980 COUNTY MONUMENT.
GEODETIC COORDINATES: **DOCUMENTS ON FILE AT:**
LATITUDE: N 42° 54' 33.140" 3106 PIERCE PARKWAY, STE. D
LONGITUDE: W 122° 52' 59.098" SPRINGFIELD, OREGON 97477
ELLIPSOID HEIGHT:
DATUM: NAD83
SOURCE: POST PROCESSED RESOURCE GRADE, AS REPORTED BY JACK SNYDER.
DATE OF INVESTIGATION: 8/30/2016
REPORT BY: ANDREW HILLMAN, SURVEY TECH.
ASSISTED BY:

THIS DOCUMENT FILED IN CS OFFICE: YES
OTHER DOCUMENT FILED WITH CS: NONE