

FILED
DATE: 11-8-2016 BY: JC
THIS SURVEY CONSISTS OF:
MAP: _____
NARRATIVE: _____
CORNER RPT: CS 65193-36
DOUGLAS COUNTY SURVEYOR

CORNER INVESTIGATION REPORT

FS INDEX ID: H-21

CORNER: S 1/16
TOWNSHIP: 31 S
RANGE: 2 W
SECTION: 11 & 12
MERIDIAN: W.M.
GCDB ID: 600560
STATE: OREGON
COUNTY: DOUGLAS
FOREST: UMPQUA
DISTRICT: TILLER
NFSL PROPERTY BOUNDARY CORNER?: YES NO

DATE: 9/13/2016

HISTORY OF VISITATIONS:

1978 - L. MOFFIT, M 70-26
1985 - L. MOFFIT, FS CORNER CARD

LINE(S) POSTED: EAST - 1978 SOUTH - 1978
MAINTAINED: EAST - 2016 SOUTH - 2016

GUARD POST(S): SOUTH-2.0 FT

CORNER HISTORY:

(1978) - ESTABLISHES CORNER, SETS IRON PIPE/BRASS CAP AND 2 BTS
(1985) - FINDS CORNER AND TREES. MAINTAINS CORNER.

MONUMENT FOUND/SET:

FOUND A 2-1/2" GALVANIZED IRON PIPE WITH A 3" BRASS CAP PROJECTING 10" ABOVE A MOUND OF STONE.

RECORD CORNER ACCESSORIES:

A 17" FIR WITH A HEALED DOUBLE BLAZE.
A 30" FIR WITH A DOUBLE HEALED BLAZE.

NEW CORNER ACCESSORIES:

NO NEW ACCESSORIES ADDED.

CORNER MAINTENANCE/OTHER INFO:

CLEAR BRUSH FROM AROUND MONUMENT AND TO BT'S. TIE FLAGGING TO MONUMENT AND GUARD POSTS, PAINT BT FACES & A 6" BAND AT HEAD HEIGHT,

GEODETIC COORDINATES:

LATITUDE: N 42° 53' 27.454"
LONGITUDE: W 122° 54' 09.783"
ELLIPSOID HEIGHT:

DATUM: WGS 84

SOURCE: USGS QUAD MAP, FOR NAVIGATION TO CORNER.


DATE OF INVESTIGATION: 8/23/2016

REPORT BY: ANDREW HILLMAN, SURVEY TECH.

ASSISTED BY: JACOB HUNT, SURVEY TECH.

DOCUMENTS ON FILE AT:

3106 PIERCE PARKWAY, STE. D
SPRINGFIELD, OREGON 97477

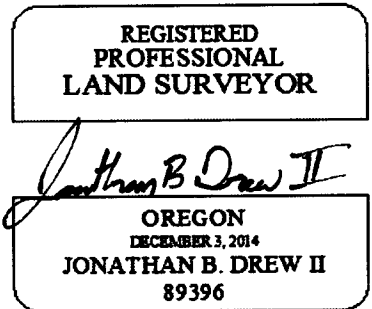

EXPIRES: 12/31/2017

RECORD MEASUREMENTS:


(N65°W - 10.7 FT)1978
(N67°E - 62.2 FT)1978

METHOD OF MEASUREMENT:

NO NEW MEASUREMENTS TAKEN.

FILED AS CONDITION REPORT.

CAP DIAGRAM:

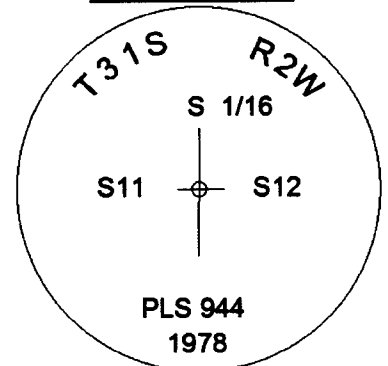

THIS DOCUMENT FILED IN CS OFFICE: YES

OTHER DOCUMENT FILED WITH CS: NONE

C.S. File No 65193-36