

FILED
DATE: 11-8-2016 BY: JC
THIS SURVEY CONSISTS OF:
MAP: _____
NARRATIVE: _____
CORNER RPT: CS 65/93-38
DOUGLAS COUNTY SURVEYOR

FS INDEX ID: G-23

CORNER INVESTIGATION REPORT

CORNER: C 1/4
TOWNSHIP: 31 S
RANGE: 2 W
SECTION: 12
MERIDIAN: W.M.
GCDB ID: 640540
STATE: OREGON
COUNTY: DOUGLAS
FOREST: UMPQUA
DISTRICT: TILLER
NFSL PROPERTY BOUNDARY CORNER?: YES NO

DATE: 9/13/2016

HISTORY OF VISITATIONS:

1978 - L. MOFFIT, M70-26

LINE(S) POSTED: NORTH - 1978 EAST - 1978

MAINTAINED: NORTH - 2016 EAST - 2016

GUARD POST(S): NORTH-5.6 FT EAST-6.0 FT

CORNER HISTORY:

(1978) - ESTABLISHES CORNER, SETS IRON PIPE/BRASS CAP AND TWO BTS.

MONUMENT FOUND/SET:

FOUND A 2-1/2" GALVANIZED IRON PIPE WITH A 3" BRASS CAP, FLUSH IN A MOUND OF STONE.

RECORD CORNER ACCESSORIES:

A 25" FIR WITH A HEALED DOUBLE BLAZE.
A 8" FIR WITH A HEALED DOUBLE BLAZE.

NEW CORNER ACCESSORIES:

NO NEW ACCESSORIES ADDED.

CORNER MAINTENANCE/OTHER INFO:

CLEAR BRUSH FROM AROUND MONUMENT AND TO BT'S. TIE FLAGGING TO MONUMENT AND GUARD POSTS, PAINT BT FACES & A 6" BAND AT HEAD HEIGHT,

GEODETTIC COORDINATES:

LATITUDE: N 42° 53' 40.147"

LONGITUDE: W 122° 53' 34.671"

ELLIPSOID HEIGHT:

DATUM: NAD83

SOURCE: POST PROCESSED RESOURCE GRADE, AS REPORTED BY JACK SNYDER.

DATE OF INVESTIGATION: 8/22/2016

REPORT BY: ANDREW HILLMAN, SURVEY TECH.

ASSISTED BY: JACOB HUNT, SURVEY TECH.

DOCUMENTS ON FILE AT:

3106 PIERCE PARKWAY, STE. D
SPRINGFIELD, OREGON 97477

THIS DOCUMENT FILED IN CS OFFICE:

YES

OTHER DOCUMENT FILED WITH CS:

NONE

REGISTERED
PROFESSIONAL
LAND SURVEYOR

Jonathan B. Drew II
OREGON
DECEMBER 3, 2014
JONATHAN B. DREW II
89396

EXPIRES: 12/31/2017

RECORD MEASUREMENTS:

(SOUTH - 3.0 FT)1978


(S69°W - 11.0 FT)1978

METHOD OF MEASUREMENT:

NO NEW MEASUREMENTS TAKEN.

FILED AS CONDITION REPORT.

CAP DIAGRAM:

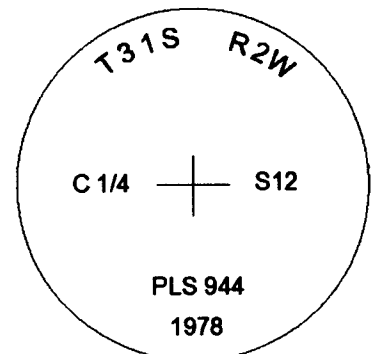

C.S. File No 65/93-38