

FILED
DATE: 11-8-2016 BY: JC
THIS SURVEY CONSISTS OF:
MAP: _____
NARRATIVE: _____
CORNER RPT: CS 65/93-45
DOUGLAS COUNTY SURVEYOR

FS INDEX ID: G-3

CORNER INVESTIGATION REPORT

CORNER: C 1/4
TOWNSHIP: 31 S
RANGE: 1 W
SECTION: 7
MERIDIAN: W.M.

GCDB ID: 140540
STATE: OREGON
COUNTY: DOUGLAS
FOREST: UMPQUA
DISTRICT: TILLER

DATE: 09/13/2016

HISTORY OF VISITATIONS:
1977 - W. RUPPERT, M65-60
2003 - L. HERZSTEIN, BLM SURVEY

NFSL PROPERTY BOUNDARY CORNER?: YES NO

LINE(S) POSTED: WEST-1977 EAST-1977

MAINTAINED: WEST-2016 EAST-2003

GUARD POST(S): WEST-2.4 FT EAST-4.8 FT

CORNER HISTORY:

(1977) - ESTABLISHED CORNER, SET IRON PIPE/BRASS CAP & 2 BT'S.
(2003) - FINDS & ACCEPTS IRON PIPE/BRASS CAP & 2 BT'S, SETS 1 NEW BT.

REGISTERED
PROFESSIONAL
LAND SURVEYOR

Jonathan B. Drew II
OREGON
DECEMBER 3, 2014
JONATHAN B. DREW II
89396

MONUMENT FOUND/SET:

FOUND A 2-1/2" GALVANIZED IRON PIPE WITH A 2-1/2" BRASS CAP, PROJECTING 2 INCHES ABOVE A MOUND OF STONE.

EXPIRES: 12/31/2017

RECORD CORNER ACCESSORIES:

A ROOT HOLE WITH A 24" CEDAR LOG WITH SCRIBE MARKS VISIBLE ON A PARTIALLY HEALED SINGLE BLAZE ALONG SIDE.
A 16" FIR WITH A HEALED DOUBLE BLAZE.
A 15" FIR WITH A HEALED SINGLE BLAZE.

RECORD MEASUREMENTS:

(S85°W - 94.0 FT)1977
(S1°45'E-43.4 FT)1977, (S2°E-43.0')2003
(S76°30'W - 41.1 FT)2003

NEW CORNER ACCESSORIES:

NO NEW ACCESSORIES ADDED.

METHOD OF MEASUREMENT:

NO NEW MEASUREMENTS TAKEN.

FILED AS CONDITION REPORT.

CORNER MAINTENANCE/OTHER INFO:

CLEAR BRUSH FROM AROUND MONUMENT AND TO BT'S. TIE FLAGGING TO MONUMENT AND GUARD POSTS, PAINT BT FACES & A 6" BAND AT HEAD HEIGHT,

GEODETTIC COORDINATES:

LATITUDE: N 42° 53' 40.437"
LONGITUDE: W 122° 52' 24.072"
ELLIPSOID HEIGHT:

DATUM: NAD83

SOURCE: POST PROCESSED RESOURCE GRADE, AS REPORTED BY JACK SNYDER.


DATE OF INVESTIGATION: 9/7/2016

REPORT BY: ANDREW HILLMAN, SURVEY TECH.

ASSISTED BY: JACOB HUNT, SURVEY TECH.

DOCUMENTS ON FILE AT:

3106 PIERCE PARKWAY, STE. D
SPRINGFIELD, OREGON 97477

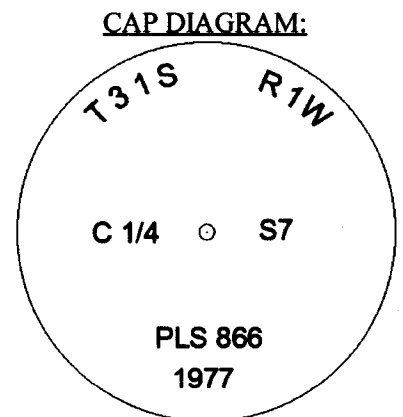

THIS DOCUMENT FILED IN CS OFFICE: YES

OTHER DOCUMENT FILED WITH CS: NONE

C.S. File No 65/93-45