

FILED
 DATE: 11-8-2016 BY: XC
 THIS SURVEY CONSISTS OF:
 MAP: _____
 NARRATIVE: _____
 CORNER RPT: CS 65/93-49
 DOUGLAS COUNTY SURVEYOR

FS INDEX ID: E-2

CORNER INVESTIGATION REPORT

CORNER: W 1/16 **GCDB ID:** 120600 **DATE:** 9/13/2016
TOWNSHIP: 31 S **STATE:** OREGON
RANGE: 1 W **COUNTY:** DOUGLAS
SECTION: 6 & 7 **FOREST:** UMPQUA
MERIDIAN: W.M. **DISTRICT:** TILLER

HISTORY OF VISITATIONS:

1967 - G. BAUGHMAN, M34-23, CS 55/41-5
 1977 - W. RUPPERT, M65-60
 1979 - K. WEAVER, M81-28, CS 58/216-5

NFSL PROPERTY BOUNDARY CORNER?: YES NO

LINE(S) POSTED: WEST-1979 SOUTH-1977 NORTH-1979 EAST-UNKNOWN

MAINTAINED: WEST-2016 SOUTH-2016 NORTH-2016 EAST-2016

GUARD POST(S): WEST-4.9 FT SOUTH-3.7 FT EAST-23.6 FT

CORNER HISTORY:

(1967) - ESTABLISHED CORNER, SET IRON PIPE/BRASS CAP & 2 BT'S
 (1977) - FINDS IRON PIPE/BRASS CAP LAYING ON GROUND, RESETS AT RECORD DISTANCE FROM THE 2 FOUND BT'S.
 (1979) - FINDS IRON PIPE/BRASS CAP & 2 BT'S.

MONUMENT FOUND/SET:

FOUND A 2-1/2" GALVANIZED IRON PIPE WITH A 2-1/2" BRASS CAP, PROJECTING 6 INCHES ABOVE HALF OF A MOUND OF STONE TO THE SW. RECENT EARTH WORK TO THE EAST OF THE CORNER HAS DISTURBED THE MOUND OF STONE BUT THE CORNER MONUMENT REMAINS SOLID.

RECORD CORNER ACCESSORIES:

A 27" FIR WITH A HEALED SINGLE BLAZE.
 A 34" OAK WITH A HEALED SINGLE BLAZE.

**REGISTERED
 PROFESSIONAL
 LAND SURVEYOR**

Jonathan B. Drew II
 OREGON
 DECEMBER 3, 2014
JONATHAN B. DREW II
 89396

EXPIRES: 12/31/2017

RECORD MEASUREMENTS:

(N63°E - 52.5 FT)1967
 (S23°E - 71.0 FT)1967

NEW CORNER ACCESSORIES:

NO NEW ACCESSORIES ADDED.

METHOD OF MEASUREMENT:

NO NEW MEASUREMENTS TAKEN.

FILED AS CONDITION REPORT.

CORNER MAINTENANCE/OTHER INFO:

CLEAR BRUSH FROM AROUND MONUMENT AND TO BT'S. TIE FLAGGING TO MONUMENT AND GUARD POSTS, PAINT BT FACES & A 6" BAND AT HEAD HEIGHT,

GEODETIC COORDINATES:

LATITUDE: N 42° 54' 06.802"
LONGITUDE: W 122° 52' 41.957"
ELLIPSOID HEIGHT:

DATUM: NAD83

SOURCE: POST PROCESSED RESOURCE GRADE, AS REPORTED BY JACK SNYDER.

DATE OF INVESTIGATION: 8/15/2016

REPORT BY: JONATHAN B. DREW II, PLS#89396, CFedS#1664


ASSISTED BY: ANDREW HILLMAN, SURVEY TECH.

JACOB HUNT, SURVEY TECH.

DOCUMENTS ON FILE AT:

3106 PIERCE PARKWAY, STE. D
 SPRINGFIELD, OREGON 97477

CAP DIAGRAM:

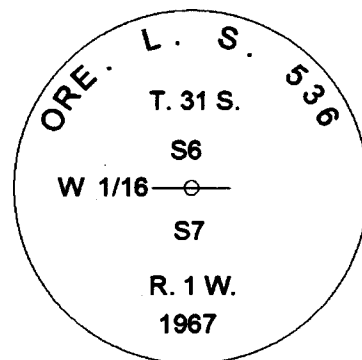

THIS DOCUMENT FILED IN CS OFFICE: YES

OTHER DOCUMENT FILED WITH CS: NONE

C.S. File No 65/93-49