

FILED
DATE: 11-8-2016 BY: JC
THIS SURVEY CONSISTS OF:
MAP: _____
NARRATIVE: _____
CORNER RPT: C565193-50
DOUGLAS COUNTY SURVEYOR

FS INDEX ID: D-2

CORNER INVESTIGATION REPORT

CORNER: SW 1/16
TOWNSHIP: 31 S
RANGE: 1 W
SECTION: 6
MERIDIAN: W.M.

GCDB ID: 120620
STATE: OREGON
COUNTY: DOUGLAS
FOREST: UMPQUA
DISTRICT: TILLER

DATE: 9/13/2016

HISTORY OF VISITATIONS:
1979 - K. WEAVER, M81-28, CS 58/216-5

NFSL PROPERTY BOUNDARY CORNER?: YES NO

LINE(S) POSTED: WEST-1979 SOUTH-1979

MAINTAINED: WEST-2016 SOUTH-2016

GUARD POST(S): WEST-3.6 FT SOUTH-4.2 FT

CORNER HISTORY:

(1979) - ESTABLISHED CORNER, SET IRON PIPE/BRASS CAP & 2 BT'S

MONUMENT FOUND/SET:

FOUND A 2-1/4" GALVANIZED IRON PIPE WITH A 2-1/2" BRASS CAP, PROJECTING 10 INCHES ABOVE A MOUND OF STONE.

RECORD CORNER ACCESSORIES:

A 14" FIR WITH A HEALED DOUBLE BLAZE.
A 16" FIR WITH A HEALED DOUBLE BLAZE.

NEW CORNER ACCESSORIES:

NO NEW ACCESSORIES ADDED.

CORNER MAINTENANCE/OTHER INFO:

CLEAR BRUSH FROM AROUND MONUMENT AND TO BT'S. TIE FLAGGING TO MONUMENT AND GUARD POSTS, PAINT BT FACES & A 6" BAND AT HEAD HEIGHT,

GEODETIC COORDINATES:

LATITUDE: N 42° 54' 20.106"
LONGITUDE: W 122° 52' 41.742"
ELLIPSOID HEIGHT:

DATUM: NAD 83

SOURCE: POST PROCESSED RESOURCE GRADE, AS REPORTED BY JACK SNYDER.

DATE OF INVESTIGATION: 8/15/2016

REPORT BY: JONATHAN B. DREW II, PLS#89396, CFedS#1664

ASSISTED BY: ANDREW HILLMAN, SURVEY TECH.
JACOB HUNT, SURVEY TECH.

DOCUMENTS ON FILE AT:

3106 PIERCE PARKWAY, STE. D
SPRINGFIELD, OREGON 97477

REGISTERED
PROFESSIONAL
LAND SURVEYOR

Jonathan B. Drew II

OREGON
DECEMBER 3, 2014
JONATHAN B. DREW II
89396

EXPIRES: 12/31/2017

RECORD MEASUREMENTS:


(S46°06'E - 13.4 FT)1979
(S36°31'W - 14.5 FT)1979

METHOD OF MEASUREMENT:

NO NEW MEASUREMENTS TAKEN.

FILED AS CONDITION REPORT.

CAP DIAGRAM:

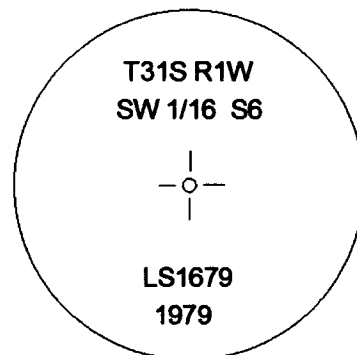

THIS DOCUMENT FILED IN CS OFFICE: YES
OTHER DOCUMENT FILED WITH CS: NONE

C.S. File No 65/93-50