

FILED

Date: 12-27-2016 By: JC

This survey consists of:

Map: _____

Narrative: _____

Corner Rpt: CS 65/93-61

DOUGLAS COUNTY
SURVEYOR

CORNER REPORT FORM

Section 12 Township 31S Range 9W
Douglas County Date 12-2-16
PLSS Number 700540

CORNER DESIGNATION

1/4 S12/S7
T31S R9W T31S RBW

- Condition Report only
- Not Found
- Renewed
- Unrecorded
- Surveyed In
- Referenced out

Previous Renewals/Surveys, etc:

BLM Resurvey 1960-1962 DCSSO RECORDS V6/31 P6/13/87
DCSSO 1981 CS FILE 61/19 De Groot 6/2001 M137-13

Monument(s) & Accessories Found: (Condition and Source)

BLM BRASS CAP

BT'S Per PLSS #700540 & M137-13

Monument Detail

Sketch

1/4
S12/S7
R9W R0W
T31S
1982

Monument Set (Procedures and Description)



New Accessories

A 6" D. FIR N 72°W 84 FT. SCRIBED 1/4 S12 BT
A 8" D. FIR N 64°E 198 FT SCRIBED 1/4 S7 BT

Surveyor's Seal

Location & Comments

Compass Declination 15 1/2° E
Firm/Agency: i.e. Engineering, Inc.
Address: 809 SE Pine St., Roseburg, OR 97470
Party Chief: N. FROINDAHL
Notes:
Witness: R. OLSON

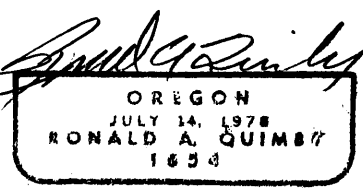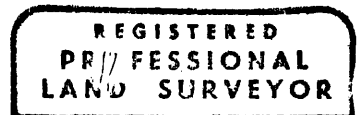

EXP 12-31-16

C.S. File 65/93-61