

FILED

Date: 1-12-2017 By: SC

This survey consists of:

Map: _____

Narrative: _____

Corner Rpt: CS 65/95-3

DOUGLAS COUNTY
SURVEYOR

CORNER REPORT FORM

Section 36 Township 31S Range 5W
Douglas County Date 11/2015
PLSS Number 640100

CORNER DESIGNATION

1/4 COR 36
1



Condition Report only
Not Found
Renewed
Unrecorded
Surveyed In
Referenced out

Previous Renewals/Surveys, etc:


SET BLM Dependent Survey 2013 DCSO Rec. Vol 58
PG. 23127

Monument(s) & Accessories Found: (Condition and Source)

BLM BRASS CAP
10" CEDAR N25 3.5' OPEN Scribes
13" FIR S34E 22.0' PARTIALLY HEATED Scribes

Monument Detail

Sketch

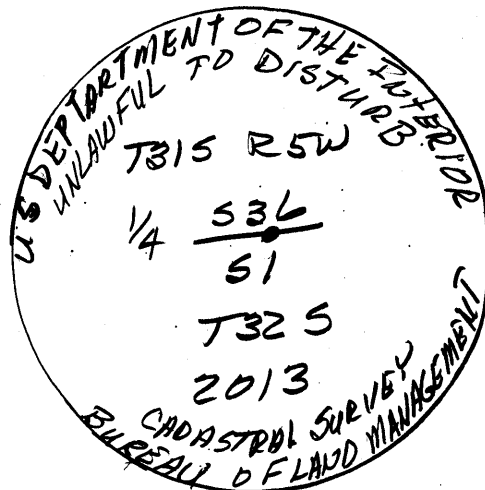

Monument Set (Procedures and Description)

New Accessories

5" FIR N36E 16.8' Scribed 1/4 S36 BT
10" CEDAR S34W 11.9' Scribed 1/4 S1 BT

Surveyor's Seal

Location & Comments

CORNER IS APPROX
150' WEST OF END OF
ROAD

HAND HELD LAT & LONG


N. 42° 49.556
W. 123° 14.296

Compass Declination 15 1/2° E
Firm/Agency: I.e. Engineering, Inc.
Address: 809 SE Pine St., Roseburg, OR 97470

Party Chief: N. FROMMHAHL

Notes:

Witness: R. OLSEN

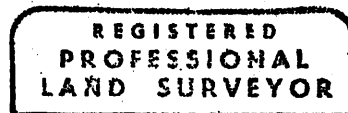

Ronald A. Quimby
OREGON
JULY 14, 1978
RONALD A. QUIMBY
1854

EXP 12-31-16

C.S. File 65/95-3