

FILED

Date: 1-12-2017 By: JC

This survey consists of:

Map: _____

Narrative: _____
Corner Rpt: CS 65/95-4

DOUGLAS COUNTY
SURVEYOR

CORNER REPORT FORM

Section 36 Township 31S Range 5W
Douglas County Date 11-2015
PLSS Number 700140

CORNER DESIGNATION

E 1/4 Sec 36 only

<input type="checkbox"/>
<input checked="" type="checkbox"/>
<input type="checkbox"/>
<input type="checkbox"/>
<input type="checkbox"/>

Condition Report only
Not Found
Renewed
Unrecorded
Surveyed In
Referenced out

Previous Renewals/Surveys, etc:


BLM 1973 SET Vol. 38 Pg. 15642

Monument(s) & Accessories Found: (Condition and Source)

3" BRASS CAP
22" FIR STUMP S10W 40³ FT (SEAR)

Monument Detail

Sketch

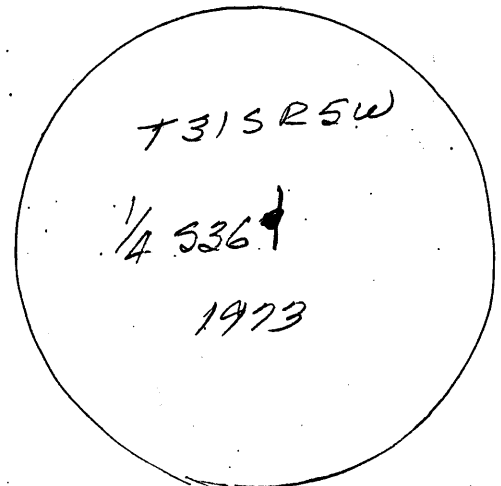

Monument Set (Procedures and Description)

New Accessories

7" D. FIR N72W 34⁰ FT
4" Hemlock S59W 23¹ FT
6" D. FIR N13W 37³ FT
50" MAPLE N4W 30⁵ FT

All scribed 1/4 536 BT

Location & Comments

CORNER IS ON
SOUTH BOUNDARY OF
OLD CLEARCUT APPROX.
100' SOUTH OF CREEK

Compass Declination 15 1/2

Firm/Agency: I.e. Engineering, Inc.



Address: 809 SE Pine St., Roseburg, OR 97470

Party Chief: N. Fromdahl

Notes:

Witness: R. OLSEN

Surveyor's Seal

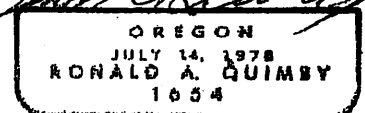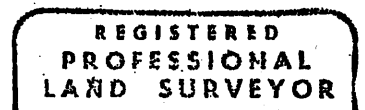

EXP 12-31-16

C.S. File 65/95-4